

APPROVED BY PEER GROUP  
P.A. 345 OF 1990  
SAGINAW COUNTY

SAGINAW COUNTY REMONUMENTATION PROJECT  
LAND CORNER RECORDATION CERTIFICATE

*Liber 7 Page 105*

3-13-96 *BOA*

Filing Requirement of Act 74, Mich. P.A. 1970

For corners in <u>Saginaw</u> (County)	Located In:	Corner Code #
Chesaning Township		
1. Public Land Survey	T 9N R 3E	E-9
	T _____	_____
	T _____	_____
	T _____	_____
	T _____	_____
2. Property Controlling in Section	S T _____	_____
	S T _____	_____
3. Miscellaneous Property in Sec.	S T _____	_____
	S T _____	_____

MILDRED M. DODAK  
 REGISTER OF DEEDS  
 SAGINAW COUNTY MICH.  
 SEP 27 3 17 PM 1996  
 RECORDED & FILED

Register of Deeds Stamp & File Number

4. Lot No. \_\_\_\_\_, Recorded Plat \_\_\_\_\_  
5. Private Claims \_\_\_\_\_

	A	B	C	D	E	F	G	H	I	J	K	L	M
1													
2	6	5	4	3	2	1							
3													
4	7	8	9	10	11	12							
5													
6	18	17	16	15	14	13							
7													
8	19	20	21	22	23	24							
9													
10	30	29	28	27	26	25							
11													
12	31	32	33	34	35	36							
13													

I, John H. Rauser, in a field survey on February 19 96, do hereby certify that under requirements of P.A. 74, Michigan P.A. of 1970, the corner points mentioned in lines 1 and 2 above were in conformance with regulations and rules therefore as required in the current manual of survey instructions of the United States Department of the Interior, Bureau of Land Management or by a decree of a Court of Law and/or that the corner points mentioned in lines 3, 4 and 5 above were in conformance with the rules of the Michigan Board of Land Surveyors or by a Decree of a Court of Law; established, re-established, monumented, re-monumented, recovered, found as expressed below:

NOTE: Not more than 4 corners, all in the same town and range, may be recorded on this certificate.

A. Description of original monument and accessories and/or subsequent restoration:

(E-9) Sec. Cor., Sec. 20, 21, 28 & 29, T9N-R3E  
 Wood post placed by J. Mullett, D.S. in 1840 during subdivision of Big Rock reservation.  
 N52°E 28lks. (18.48') 36" Pine  
 S77°W 24lks. (15.84') 36" Pine  
 1948 Spicer Engineering Field Notes, Fnd 1 3/4" pipe 2' deep raised, w/ 3/4" pipe flush with top.  
 1965 Unrecorded survey by J.F. Quine, P.S. #10704  
 1971 Unrecorded survey by Rowe Eng. Inc. Job No. F-3176-71  
 1976 L.C.R.C. by J.W. Martin, P.S. #4699 Rec. in L.3 P.161 Saginaw Co. Records  
 1978 Unrecorded survey by M.L. Vanraemdonck, P.S. #24622 Job #S0689-78  
 1978 Act 132 survey by M.L. Vanraemdonck, P.S. 24622 Rec.L.1557, P.390 Saginaw Co. Records  
 1979 Act 132 survey by M.L. Vanraemdonck, P.S. #24622 Rec. L. 1571, P. 1707 Saginaw Co. Records  
 1981 Act 132 survey by M.L. Vanraemdonck, P.S. #24622 Rec. L. 1603, P. 2285 Saginaw Co. Records  
 1985 Act 132 survey by J.N. Owens, P.S. #20709 Rec. L. 1682, P. 1087 Saginaw Co. Records  
 1990 Act 132 survey by M.L. Vanraemdonck, P.S. #24622 Rec. L. 1784, P. 429 Saginaw Co. Records  
 1990 Act 132 survey by M.L. Vanraemdonck, P.S. #24622 Rec. L. 1784, P. 431 Saginaw Co. Records  
 1995 Act 132 survey by J.H. Rauser, P.S. #39096 Rec. L. 1957, P. 413 Saginaw Co. Records


B. Description of corner evidence found and/or method applied in restoring or reestablishing corner:

E-9 Sec. Cor., Sec. 20, 21, 28, & 29, T9N-R3E  
 Found no evidence of original government survey.  
 Found 3/8" Re-Rod placed above a 3/4" pipe below asphalt surface as per 1965 survey by J. Quine as stated above. Found re-rod verified by witnesses dating back to 1948 Spicer Engineering, field note witnesses, and is accepted as the best available evidence of the position of the original corner.

C. Description of monument for corner and accessories established to perpetuate locating the position of the corner:

E-9 Sec. Cor., Sec 20, 21, 28, & 29, T9N-R3E  
 Placed 5/8" re-rod w/ "Saginaw County Monument" brass cap, stamped P.S. 39096 and monument box.  
 N40°E 66.20' N&T #39096 NW Fce 18" Maple  
 North 33.01' 1" pipe w/cap #4699  
 S45°W 38.85' N&T #39096 SE Fce Twin Pines  
 S63°E 75.96' NW Cor. Smith Tombstone (R= 75.93' 1948)  
 South 24.18' N&T #39096 E. Fce 12" Pine  
 SW 58.90' NE Cor. Bauer Tombstone (R= 58.93' 1948)

Signed by John H. Rauser Date Sept 27 1996  
 Surveyor's Michigan License No. 39096

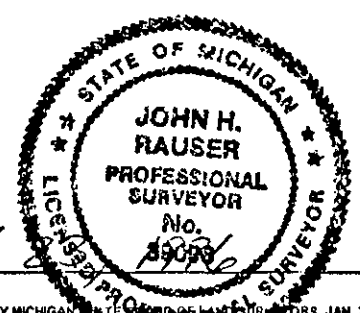

MAY 16 1997