

APPROVED BY PEER GROUP P.A. 345 OF 1990 SAGINAW COUNTY LAND CORNER RECORDATION CERTIFICATE

Liber 7 Page 108

9-4-96 [Signature]

Filing Requirement of Act 74, Mich. P.A. 1970

RECORDED & FILED MILDRED M. DODAK REGISTER OF DEEDS SAGINAW COUNTY MICH. SEP 27 3 17 PM 1996

Table with columns: For corners in Saginaw (County) Chesaning Township, Located In: T 9N R 3E, Corner Code # F-3. Rows include Public Land Survey, Property Controlling in Section, and Miscellaneous Property in Sec.

Register of Deeds Stamp & File Number

4. Lot No. Recorded Plat 5. Private Claims

Grid table with columns A-M and rows 1-13. Contains numbers 1-36 in a grid pattern.

I, John H. Rauser, in a field survey on April 8-12, 1996, do hereby certify that under requirements of P.A. 74, Michigan P.A. of 1970, the corner points mentioned in lines 1 and 2 above were in conformance with regulations and rules therefore as required in the current manual of survey instructions of the United States Department of the Interior, Bureau of Land Management or by a decree of a Court of Law and/or that the corner points mentioned in lines 3, 4 and 5 above were in conformance with the rules of the Michigan Board of Land Surveyors or by a Decree of a Court of Law; established, re-established, monumented, re-monumented, recovered, found as expressed below:

NOTE: Not more than 4 corners, all in the same town and range, may be recorded on this certificate.

A. Description of original monument and accessories and/or subsequent restoration:

F-3 1/4 Cor., Sec. 4 & 9, T9N-R3E

Wood Post placed by J. Mullett, P.S. in 1840 during subdivision of Big Rock Preserve. East 15 lks (9.9') 9" Beech S 71 W 29 lks (19.14') 8" Beech

1868 Corner found & witnessed by Saginaw County Surveyor Records April 6, 1868 N 6 E, 56 lks (36.96') 22" Elm 1956-1993 Spicer Engineering field notes: Used position of 1/4 corner, which is consistent throughout 1968 Unrecorded survey by Edmonds Engineering, Inc. dated 9/13/68 1974 Act 132 Survey by A. H. Leach, P.S. #7236, Rec. L. 1440, P. 595, Saginaw County Records. 1975, L.C.R.C. by A.H. Leach, P.S. #7236, Rec. L. 3, P. 89, Saginaw County Records.

B. Description of corner evidence found and/or method applied in restoring or reestablishing corner:

F-3 1/4 Cor., Sec. 4 & 9, T9N-R3E

Found no evidence of original government corner. Found 3/4" iron pipe flush with asphalt pavement as established by Spicer Engineering. Found hole in asphalt at a position which agrees with surveys as recorded (No iron in hole or below surface). The position of the hole in the asphalt was established by a 1968 unrecorded Edmonds Engineering, Inc. survey for Consumers Power Company. The surveys of record use this position for reference only. Spicer Engineering has performed numerous surveys in Sections 4 and 9, T9N-R3E, using the position of the 3/4" pipe. The position of the 3/4" pipe has remained consistent since 1956 and many title lines have been established from this position.

The entire area in the vicinity of the two positions was excavated to a depth of 3 feet in order to search for evidence of the original position of the corner. No evidence was recovered at either position.

So as not to disrupt long established title lines the found 3/4" pipe is accepted as the best available evidence of the position of the original corner.


C. Description of monument for corner and accessories established to perpetuate locating the position of the corner:

F-3 1/4 Cor., Sec. 4 & 9, T9N-R3E

Set 5/8" iron re-rod with "Saginaw County Monument" brass cap, stamped P.S. 39096 and placed monument box.

N20W 32.80' Fnd spike w/tag in SW fce TP S35E 100.85' Fnd spike w/tag in N. T/P South 33.07' Fnd re-rod w/cap #24612 N02W 46.15' Center chain link fence post North 45.30' Center chain link fence post

Signed by [Signature] Date Sept 24 1996 Surveyor's Michigan License No. 39096

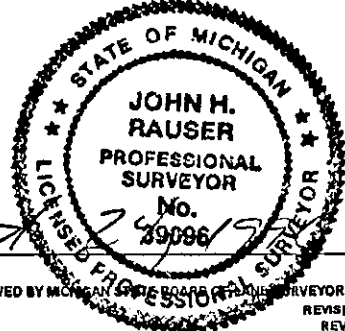

FORM APPROVED BY MICHIGAN SURVEYORS BOARD OF PROFESSIONAL SURVEYORS, JAN. 28, 1971 REVISED MAY 14, 1975 REVISED JAN. 1983 ADAPTED FOR WORD PROCESSING MARCH, 1993

MAY 16 1997

COMMISSION