

APPROVED BY PEER GROUP  
P.A. 345 OF 1990 SAGINAW COUNTY REMONUMENTATION PROJECT  
SAGINAW COUNTY LAND CORNER RECORDATION CERTIFICATE

Liber 7 Page 106

8-7-96 [Signature] Filing Requirement of Act 74, Mich. P.A. 1970

MILDRED M. DODAK  
REGISTER OF DEEDS  
SAGINAW COUNTY MICH.

SEP 27 3 17 PM 1996

RECORDED & FILED

For corners in	Located In:	Corner Code #
Saginaw (County) Chesaning Township		
1. Public Land Survey	T 9N R 3E	F-5
	T R	
	T R	
	T R	
2. Property Controlling in Section	S T R	
	S T R	
3. Miscellaneous Property in Sec.	S T R	
	S T R	

Register of Deeds Stamp & File Number

4. Lot No. \_\_\_\_\_, Recorded Plat \_\_\_\_\_  
5. Private Claims \_\_\_\_\_

	A	B	C	D	E	F	G	H	I	J	K	L	M
1													
2	6	5	4	3	2	1							
3													
4	7	8	9	10	11	12							
5													
6	18	17	16	15	14	13							
7													
8	19	20	21	22	23	24							
9													
10	30	29	28	27	26	25							
11													
12	31	32	33	34	35	36							
13													

I, John H. Rauser, in a field survey on April 8-12, 1996, do hereby certify that under requirements of P.A. 74, Michigan P.A. of 1970, the corner points mentioned in lines 1 and 2 above were in conformance with regulations and rules therefore as required in the current manual of survey instructions of the United States Department of the Interior, Bureau of Land Management or by a decree of a Court of Law and/or that the corner points mentioned in lines 3, 4 and 5 above were in conformance with the rules of the Michigan Board of Land Surveyors or by a Decree of a Court of Law; established, re-established, monumented, re-monumented, recovered, found as expressed below.

NOTE: Not more than 4 corners, all in the same town and range, may be recorded on this certificate.

A. Description of original monument and accessories and/or subsequent restoration:

F-5 1/4 Cor., Sec. 9 & 16, T9N-R3E

- 1840 J. Mullett, P.S. during subdivision of Big Rock Preserve, called for a 9" Beech for corner.
- 1867 Map of Chapman's Addition to the Village of Chesaning I.H. Levenworth, Surveyor
- 1868 Map of Clark's Addition to the Village of Chesaning, I.H. Levenworth, Surveyor
- 1946 Spicer Engineering field notes, points set at street intersections along Brady Street on Sec. line, Sec. 9 & 16
- 1947 Spicer Engineering field notes, meas. dist. along N-S 1/4 line F-6 to F-7
- 1951 Spicer Engineering field notes, tie to pipe N. of F-5 on N-S 1/4 line
- 1961 Spicer Engineering field notes, points set at street intersections along Brady Street on Sec. line, Sec. 9 & 16.
- 1981 unrecorded survey by J.S. Fokens, P.S. #21567, Job No. F-6867-81-S
- 1981 unrecorded survey by J.S. Fokens, P.S. #21567, Job No. F-6930-81-S
- 1988 L.C.R.C. by J.D. Matonich, Jr., P.S. #31598, rec. L. 1738, P. 1107, Saginaw County Records.
- 1988 unrecorded plat of survey by J.D. Matonich, Jr., P.S. #31598
- 1994 Spicer Engineering, field notes

B. Description of corner evidence found and/or method applied in restoring or reestablishing corner:

F-5 1/4 Cor., Sec. 9 & 16


Found no evidence of original government corner. Found P.K. Nail in asphalt surface. Position of PK Nail used on numerous surveys within the Village of Chesaning as stated in "A" above. Verified position with measurements to record corner positions N-S-W of PK. Measured angle and distance between F-5, F-6 & F-7 (Dist F-5 to F-6 2643.59'; angle F-5, F-6, F-7 180°-00'-56"; Dist F-6 to F-7 = 2625.52' (R= 2625.35', 1947); measured North to rec. pipe on N-S 1/4 line, Sec. 9, 362.96 (R= 363.00', 1951); Dist F-5 to E-5 = 2633.92', (R= 2633.98', 1994 Spicer, R= 2633.79', 1946-1961 Spicer) Found monument is accepted as the best available evidence of the position of the original corner.

C. Description of monument for corner and accessories established to perpetuate locating the position of the corner:

F-5 1/4 Cor., Sec. 9 & 16, T9N-R3E

- Set 5/8" re-rod with "Saginaw County Monument", brass cap stamped P.S. 39096 at the position of the pk nail, placed monument box.
- N45°W 34.14' Set new pk w/tag 39096 in SW Fce p/p (R=33.98')
- N45°E 32.15' Set new pk w/tag 39096 in SE Fce p/p (R=32.10')
- S45°E 36.68' Set new pk w/tag 39096 in SW Fce p/p (R=36.82')
- S20°W 118.80' Set new pk w/tag 39096 in E Fce p/p

Signed By John H. Rauser Date Sept 29 1996  
Surveyor's Michigan License No. 39096

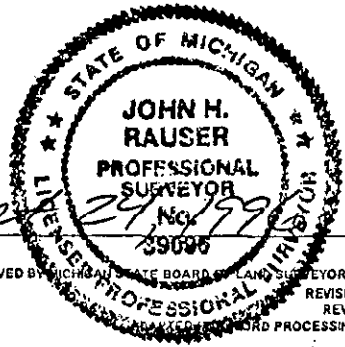

MAY 1 9 1997