

APPROVED BY PEER GROUP  
P.A. 345 OF 1990  
SAGINAW COUNTY

SAGINAW COUNTY REMONUMENTATION  
LAND CORNER RECORDATION CERTIFICATE

*Liber 7 Page 107*

Filing Requirement of Act 74, Mich. P.A. 1970

For corners in  
Saginaw  
(County)  
Chesaning Township

Located In:

Corner Code #

1. Public Land Survey	T	9N	R	3E	F-7
	T		R		
	T		R		
	T		R		
2. Property Controlling in Section	S	T	R		
	S	T	R		
3. Miscellaneous Property in Sec.	S	T	R		
	S	T	R		

MILDRED M. DODAK  
REGISTER OF DEEDS  
SAGINAW COUNTY MICH.

SEP 27 3 17 PM 1986

RECORDED & FILED

Register of Deeds Stamp & File Number

4. Lot No. \_\_\_\_\_, Recorded Plat \_\_\_\_\_  
5. Private Claims \_\_\_\_\_

	A	B	C	D	E	F	G	H	I	J	K	L	M
1													
2	6		5		4		3		2		1		
3													
4	7		8		9		10		11		12		
5													
6	18		17		16		15		14		13		
7													
8	19		20		21		22		23		24		
9													
10	30		29		28		27		26		25		
11													
12	31		32		33		34		35		36		
13													

I, John H. Rauser, in a field survey on May 6, 19 96, do hereby certify that under requirements of P.A. 74, Michigan P.A. of 1970, the corner points mentioned in lines 1 and 2 above were in conformance with regulations and rules therefore as required in the current manual of survey instructions of the United States Department of the Interior, Bureau of Land Management or by a decree of a Court of Law and/or that the corner points mentioned in lines 3, 4 and 5 above were in conformance with the rules of the Michigan Board of Land Surveyors or by a Decree of a Court of Law; established, re-established, monumented, re-monumented, recovered, found as expressed below:

NOTE: Not more than 4 corners, all in the same town and range, may be recorded on this certificate.

A. Description of original monument and accessories and/or subsequent restoration:

F-7 1/4 Corner, Section 16 & 21, T9N-R3E

Wood post placed by J. Mullett, D.S. in 1840 during subdivision of Big Rock Reserve  
N12°E 15 lks. (9.9') 6" B.Oak  
S85°E 5 lks. (3.3') 12" W.Oak  
1891, "Map of Mason's Addition to the Village of Chesaning", Description for plat recorded in Liber 2, Page 12 SCR, described the Interior 1/4 corner of Section 16 to be a cast iron post with brick, similar to the object found at the subject corner.  
1946, Spicer Engineering field notes, Fnd 1" square iron bar on end 8" below surface gravel road  
1978, Saginaw Co. Rd. Comm. Records, Fnd 3/4" iron pipe - Corner @ Sharon Rd. & Sec. line 16 & 21  
1978, Act 132 survey by J.S. Fokens, P.S.#21567 Rec. L.1529, P.61 Saginaw Co. Records.  
1979, L.C.R.C. by J.S. Fokens, P.S.#21567 Rec. L.5, P.54 Saginaw Co. Records.  
1979, L.C.R.C. by R.C. Prevost, P.S.#24612 Rec. L.5, P.31 Saginaw County Records  
1982, Act 132 survey by J.S. Fokens, P.S.#21567 Rec. L.1614, P.772 Saginaw Co. Records.  
1984, Act 132 survey by D.T. Rowe, P.S.#11192 Rec. L.1644, P.1604 Saginaw Co. Records.

B. Description of corner evidence found and/or method applied in restoring or reestablishing corner:

F-1 1/4 Corner, Section 16 & 21, T9N-R3E


Found no evidence of original government corner.  
Found 3/4" pipe flush with asphalt surface, could not verify with 1946 Spicer witnesses due to obliteration. Also found PK nail South, 2.4 feet (PK nail removed and nothing was found below). Found pipe, fit witnesses from 1978 as stated above. Excavated for placement of monument box, found 1" x 1 1/2" square cast iron bar 1.1' long below 3/4" pipe 1.6' below asphalt grade. Same object as stated in 1946 Spicer Engineering field notes. Measured North and West to F-5 and E-7 consistent with records. Found monument is accepted as the best available evidence of the position of the original corner.

C. Description of monument for corner and accessories established to perpetuate locating the position of the corner:

F-1 1/4 Corner, Section 16 & 21, T9N-R3E

Placed 5/8" Re-Rod w/"Saginaw County Monument" Brass Cap, Stamped P.S. 39096 and Monument Box.  
N30°E 43.30' Set PK w/tag 39096 NW fce. T/P  
N10°E 18.05' Set chis. "+" S rim of St.MH  
S50°E 101.78' Set nail w/tag 39096 SW fce. 12" Tw.Elm  
S45°W 30.77' Set nail w/tag 39096 NW fce. L/P

Signed by John H. Rauser Date Sept. 23, 1986  
Surveyor's Michigan License No. 39096

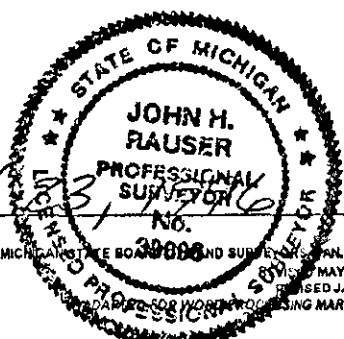

FORM APPROVED BY MICHIGAN STATE BOARD OF LAND SURVEYORS, MAY 14, 1975  
REVISED JAN, 1983  
ADAPTED FOR WORK PROCESSING MARCH, 1983

MAY 1 8 1987