

APPROVED BY PEER GROUP  
P.A. 345 OF 1990  
SAGINAW COUNTY

SAGINAW COUNTY REMONUMENTATION  
LAND CORNER RECORDATION CERTIFICATE  
Filing Requirement of Act 74, Mich. P.A. 1970

*Liber 7 Page 99*

MILDRED H. DODAK  
REGISTER OF DEEDS  
SAGINAW COUNTY MICH.

SEP 27 3 16 PM 1986

RECORDED & FILED

Register of Deeds Stamp & File Number

For corners in Saginaw (County) Chesaning Township	Located In:	Corner Code #
1. Public Land Survey	T 9N R 3E	G-3
	T R	
	T R	
	T R	
	T R	
2. Property Controlling in Section	S T R	
	S T R	
3. Miscellaneous Property in Sec.	S T R	
	S T R	

4. Lot No. \_\_\_\_\_, Recorded Plat \_\_\_\_\_  
5. Private Claims \_\_\_\_\_

I, John H. Rauser, in a field survey on February 13 19 96, do hereby certify that under requirements of P.A. 74, Michigan P.A. of 1970, the corner points mentioned in lines 1 and 2 above were in conformance with regulations and rules therefore as required in the current manual of survey instructions of the United States Department of the Interior, Bureau of Land Management or by a decree of a Court of Law and/or that the corner points mentioned in lines 3, 4 and 5 above were in conformance with the rules of the Michigan Board of Land Surveyors or by a Decree of a Court of Law; established, re-established, monumented, re-monumented, recovered, found as expressed below:

1	A	B	C	D	E	F	G	H	I	J	K	L	I
2		6	5	4	3	2	1						
3													
4		7	8	9	10	11	12						
5													
6		18	17	16	15	14	13						
7													
8		19	20	21	22	23	24						
9													
10		30	29	28	27	26	25						
11													
12		31	32	33	34	35	36						
13													

NOTE: Not more than 4 corners, all in the same town and range, may be recorded on this certificate.

A. Description of original monument and accessories and/or subsequent restoration:


G-3 Section Corner, Section 3, 4, 9 & 10, T9N-R3E  
Wood post placed by J. Mullett, D.S. in 1840 during subdivision of Big Rock Reserve  
N48°W 9 lks. (5.94') 8" Pine  
S69°E 67 lks. (44.22') 14" W. Oak  
1877, County survey by H.G. Ives, Deputy Co. Surveyor, A stone buried in center of highway.  
1971, Act 132 surveys by O.M. Elliot, P.S.#2097 Rec. L.1357, P.468-471, Saginaw Co. Records.  
1973, L.C.R.C. by J.W. Martin, P.S.#4699 Rec. L.2,P.116 Saginaw Co. Records.  
1973, Spicer Engineering Field Notes, Fnd 1/2" Boat Spike in monument box.  
1974, Act 132 survey by A. H. Leach, P.S.#7236 Rec. L.3,P.89, Saginaw Co. Records.  
1975, L.C.R.C. by A.H. Leach, P.S.#7236, Rec. L.3,P.89, Saginaw County Records.  
1984, Act 132 Survey by M.L. Vanraemdonck, P.S.#24622 Rec. L.1651,P.295 Saginaw County Records.  
Undated Saginaw Co. Rd. Comm. plans shows reference to cor.

B. Description of corner evidence found and/or method applied in restoring or reestablishing corner:

G-3 Section Corner, Section 3, 4, 9 & 10, T9N-R3E  
Found 1/2" square iron (boat spike) in monument box, Fnd no evidence of original government corner or County Survey Records. Verified with 1971 O.M. Elliot witnesses, and witness from record as stated in "A" above. Also checked distances as shown on undated Saginaw County Road Commission plans to be in agreement with record. Found monument is accepted as the best available evidence of the position of the original corner.

C. Description of monument for corner and accessories established to perpetuate locating the position of the corner:

G-3 Section Corner, Section 3, 4, 9 & 10, T9N-R3E  
Place 5/8" Re-Rod w/"Saginaw County Monument" Brass Cap stamped P.S. 39096 in existing monument box.  
N45°E 54.90' Set PK w/tag 39096 S fce. T/P  
N50°W 68.14' SE corner foundation house #14998 (R=68.29)  
S75°W 66.95' Set nail w/tag 39096 N fce. 10" Red Oak  
S60°W 47.55' Set PK w/tag 39096 N fce PP

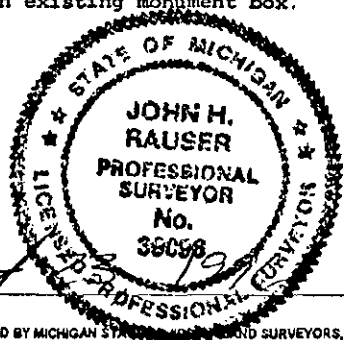

Signed by John H. Rauser Date Sept 27 1986  
Surveyor's Michigan License No. 39096

MAY 16 1997