

APPROVED BY PEER GROUP P.A. 345 OF 1990 SAGINAW COUNTY LAND CORNER RECORDATION CERTIFICATE Filing Requirement of Act 74, Mich. P.A. 1970

Libert Page 16

MILDRED M. DODAK REGISTER OF DEEDS SAGINAW COUNTY MICH.

SEP 27 3 16 PM '96

RECORDED & FILED

Register of Deeds Stamp & File Number

For corners in Saginaw County Located In: Chesaning Township Corner Code # 1. Public Land Survey T 9N R 3E G-4

4. Lot No. Recorded Plat 5. Private Claims

I, do hereby certify that under requirements of P.A. 74, Michigan P.A. of 1970, the corner points mentioned in lines 1 and 2 above were in conformance with regulations and rules therefore as required in the current manual of survey instructions of the United States Department of the Interior, Bureau of Land Management or by a decree of a Court of Law and/or that the corner points mentioned in lines 3, 4 and 5 above were in conformance with the rules of the Michigan Board of Land Surveyors or by a Decree of a Court of Law; established, re-established, monumented, re-monumented, recovered, found as expressed below:

NOTE: Not more than 4 corners, all in the same town and range, may be recorded on this certificate.

A. Description of original monument and accessories and/or subsequent restoration:

G-4 1/4 Corner, Section 9 & 10, T9N-R3E

Wood post placed by J. Mullett, D.S. in 1840 during subdivision of Big Rock Reserve East 15 lks. (9.9') 8" W. Oak N50°W 41 lks. (27.06') 10" B. Oak 1872, County survey by H.G. Ives, Deputy County Surveyor S79 3/4°W 53 lks. (34.98') 24" Sugar N29 1/4°W 95 lks. (62.7') 30" W. Oak stump 1973, L.C.R.C. by J.W. Martin, P.S. #4699 Rec. L.2,P.116 Saginaw County Records 1974, Act 132 survey by A.H.Leach, P.S.#7236 Rec. L.1440, P.595 Saginaw County Records 1975, L.C.R.C. by A.H. Leach, P.S.#7236 Rec. L.3,P.89 Saginaw County Records 1984, Act 132 Survey by M.L. Vanraendonck, P.S.#24622 Rec. L.1651,P.294 Saginaw Country Records

B. Description of corner evidence found and/or method applied in restoring or reestablishing corner:


G-4 1/4 Corner, Section 9 & 10, T9N-R3E

Fnd no evidence of Original Government Corner or County survey record witnesses. Used record 1973 witnesses to locate nail 3" ± below asphalt surface. Fnd conc. nail as called for in 1973 J. Martin L.C.R.C. Fnd monumentation of parcels as described in L.1932,P.2057; L.1899,P.2175; L.1895,P.1487; L.1894,P.795 Saginaw County Records in agreement with position of found monument. Fnd no evidence to dispute position of this monument and is accepted as the best available evidence of the position of the original corner.

C. Description of monument for corner and accessories established to perpetuate locating the position of the corner:

G-4 1/4 Corner, Section 9 & 10, T9N-R3E

Set 5/8" Iron Re-Rod w/"Saginaw County Monument" brass cap, in C/L of Corunna Road and in line with very old decayed fence to the West and placed monument box N20°E 104.03' Set PK w/tag #39096 in W fce telephone pole S20°E 94.32' Set PK w/tag #39096 in SW fce telephone pole S45°E 82.46' Corner conc. foundation of house WNW S70°E 75.65' Corner conc. foundation of porch NW N20°W 61.53' Fnd re-rod #24622

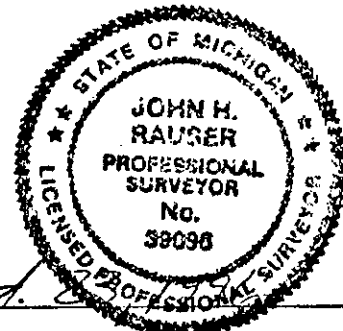

Signed by John H. Rauser Date Sept. 26 Surveyor's Michigan License No. 39096

MAY 16 1997

COMMISSION