

APPROVED BY PEER GROUP
P.A. 345 OF 1990 SAGINAW COUNTY REMONUMENTATION PROJECT
SAGINAW COUNTY LAND CORNER RECORDATION CERTIFICATE
Filing Requirement of Act 74, Mich. P.A. 1970

Lib 7 Page 96

For corners in Saginaw Located In: _____ Corner Code # _____
 (County)
 Chesaning Township

1. Public Land Survey	T	9N	R	3E	G-7
	T		R		
	T		R		
	T		R		
2. Property Controlling in Section	S		T	R	
	S		T	R	
3. Miscellaneous Property in Sec.	S		T	R	
	S		T	R	

MILDRED M. DODAK
REGISTER OF DEEDS
SAGINAW COUNTY MICH.

SEP 27 3 16 PM 1996

RECORDED & FILED

Register of Deeds Stamp & File Number

4. Lot No. _____, Recorded Plat _____
5. Private Claims _____

1	A	B	C	D	E	F	G	H	I	J	K	L	M
2	6	5	4	3	2	1							
3													
4	7	8	9	10	11	12							
5													
6	18	17	16	15	14	13							
7													
8	19	20	21	22	23	24							
9													
10	30	29	28	27	26	25							
11													
12	31	32	33	34	35	36							
13													

I, John H. Rauser, in a field survey on April 19 96, do hereby certify that under requirements of P.A. 74, Michigan P.A. of 1970, the corner points mentioned in lines 1 and 2 above were in conformance with regulations and rules therefore as required in the current manual of survey instructions of the United States Department of the Interior, Bureau of Land Management or by a decree of a Court of Law and/or that the corner points mentioned in lines 3, 4 and 5 above were in conformance with the rules of the Michigan Board of Land Surveyors or by a Decree of a Court of Law; established, re-established, monumented, re-monumented, recovered, found as expressed below:

NOTE: Not more than 4 corners, all in the same town and range, may be recorded on this certificate.

A. Description of original monument and accessories and/or subsequent restoration:

G-7 Section Corner 15, 16, 21, 22, T9N-R3E

Wood post placed by J. Mullett, D.S. in 1840 during the Subdivision of Big Rock Reserve
S85°E 36 lks. (23.76') 36" W. Oak
N84°W 43 lks. (28.38') 40" W. Oak
1851, Plat of the Village of Chesaning, Andrew Huggins, Surveyor
1946, Spicer Engineering field notes, which they copied from County Road Commission office. Fnd 2"
Wood Stake 8" below pavement.
1954, Sunnyside Subdivision, L.8,P.27 O.M. Elliot #2097
1967, Sunnyside Subdivision #2, L.16,P.42 Spicer Engineering John W. Martin #4699
1974, Saginaw County Road Commission records
1977, L.C.R.C. by J.W.Martin, P.S.#4699 Rec. L.4,P.74, Saginaw County Records.
1982, Act 132 survey by J.S. Fokens, P.S.#21567 Rec. L.1614,P.771, Saginaw County Records.
1985, Act 132 survey by M.L.Vanraemdonck, P.S.#24622 Rec.L.1669,P.23, Saginaw County Records.

B. Description of corner evidence found and/or method applied in restoring or reestablishing corner:

G-7 Section Corner 15, 16, 21, 22, T9N-R3E


Fnd 3/4" pipe in monument box in C/L of Corunna Rd. on the W'ly extension of C/L M-57. Fnd no evidence of original government survey. Verified pipe with 1949 Spicer Engineering witness to C/L of hydrant. R = 35.88' (M = 35.95'). Found monument also in agreement with more recent records as stated in "A" above. Measured South to G-8 M = 2627.53' (MDOT = 2627.30'). Found monument is accepted as the best available evidence of the position of the original corner.

C. Description of monument for corner and accessories established to perpetuate locating the position of the corner:

G-7 1/4 Corner, Section 21 and 22, T9N-R3E

Placed 5/8" Re-Rod w/"Saginaw County Monument" brass cap stamped P.S. 39096
West 49.58' Set PK w/tag 39096 P/P
S70°E 46.47' Set PK w/tag 39096 T/P
S50°E 35.95' T/C fire hydrant (R = 35.88')
S30°E 121.90' Set PK w/tag 39096 P/P

Signed by John H. Rauser Date Sept. 27 1996
Surveyor's Michigan License No. 39096

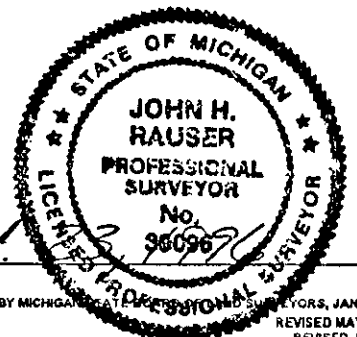

FORM APPROVED BY MICHIGAN BOARD OF PROFESSIONAL SURVEYORS, JAN. 28, 1971
REVISED MAY 14, 1975
REVISED JAN., 1983
ADAPTED FOR WORD PROCESSING MARCH, 1993

MAY 1 8 1997