

Liber 7 Page 97

For corners in
Saginaw
(County)
Chesaning Township

Located In:

Corner Code #

1. Public Land Survey	T	9N	R	3E	G-8
	T		R		
	T		R		
	T		R		
2. Property Controlling in Section	S	T	R		
	S	T	R		
3. Miscellaneous Property in Sec.	S	T	R		
	S	T	R		

MILDRED H. DODAK
REGISTER OF DEEDS
SAGINAW COUNTY MICH.

SEP 27 3 16 PM 1986

RECORDED & FILED

Register of Deeds Stamp & File Number

4. Lot No. _____, Recorded Plat _____
5. Private Claims _____

I, John H. Rauser, in a field survey on February 14 19 96, do hereby certify that under requirements of P.A. 74, Michigan P.A. of 1970, the corner points mentioned in lines 1 and 2 above were in conformance with regulations and rules therefore as required in the current manual of survey instructions of the United States Department of the Interior, Bureau of Land Management or by a decree of a Court of Law and/or that the corner points mentioned in lines 3, 4 and 5 above were in conformance with the rules of the Michigan Board of Land Surveyors or by a Decree of a Court of Law; established, re-established, monumented, re-monumented, recovered, found as expressed below:

	A	B	C	D	E	F	G	H	I	J	K	L	M
1													
2	6	5	4	3	2	1							
3													
4	7	8	9	10	11	12							
5													
6	18	17	16	15	14	13							
7													
8	19	20	21	22	23	24							
9													
10	30	29	28	27	26	25							
11													
12	31	32	33	34	35	36							
13													

NOTE: Not more than 4 corners, all in the same town and range, may be recorded on this certificate.

A. Description of original monument and accessories and/or subsequent restoration:

G-8 1/4 Corner, Section 21 and 22, T9N-R3E

A wood post placed by J. Mullett, D.S. in 1840 during the subdivision of Big Rock Reserve
N78°E 30 lks (19.80') 16" Beech
S45°W 21 lks (13.86') 8" Ironwood
1953, Spicer Engineering field notes, dug and found wooden stake and small stone 10" below surface, set 3/4" pipe 6" below bituminous surface on fence line to East and West
1963, Michigan State Hwy. Dept. records by Jack Floyd
1974, Saginaw County Road Commission records find 3/4" iron pipe
1975, L.C.R.C. by J.W. Martin, P.S. #4699 Rec. in L.3,P.119 Saginaw Co. Records Spicer Engineering Co.
1975, Unrecorded survey by J.W.Martin, P.S.#1699, Spicer Engineering, Co.Job #17582, Dwg No. A-9648-1

B. Description of corner evidence found and/or method applied in restoring or reestablishing corner:

G-8 1/4 Corner, Section 21 and 22, T9N-R3E

Find no evidence of original government corner. Find 3/4" pipe in monument box, 1.5'± W of C/L of asphalt, verified 3/4" pipe with 1953 Spicer Engineering witness to the NE corner block foundation 122.95 = R (122.60 = M to vinyl siding) and other records as stated in "A" above. Measured = 2627.53 North to G-7 (MDOT = 2627.30'). Found monument is accepted as the best available evidence of the position of the original corner.


C. Description of monument for corner and accessories established to perpetuate locating the position of the corner:

G-8 1/4 Corner, Section 21 and 22, T9N-R3E

Placed 5/8" rerod w/"Saginaw County Monument" brass cap stamped P.S. 39096 in existing monument box.
West 56.53' Set PK w/tag 39096 P/P
N40°W 43.50' Punch hole N end plastic tile
S70°E 49.92' Set nail w/tag 39096 N fce 30" maple
S85°E 149.45' Set nail w/tag 39096 N fce 36" Oak

Signed by John H. Rauser
Surveyor's Michigan License No. 39096

Date Sept 23 1986

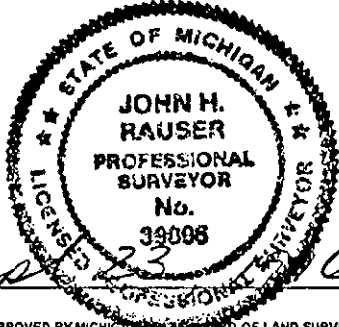

MAY 18 1987