

APPROVED BY PEER GROUP

LIBER 1986 PAGE 513

P.A. 345 OF 1990 SAGINAW COUNTY REMONUMENTATION PROJECT

*Liber 7 Page 98*

SAGINAW COUNTY LAND CORNER RECORDATION CERTIFICATE

3-13-96 Filing Requirement of Act 74, Mich. P.A. 1970

For corners in <u>Saginaw</u> <small>(County)</small>	Located In:	Corner Code #
<u>Chesaning Township</u>		
1. Public Land Survey	T <u>9N</u> R <u>3E</u>	<u>G-9</u>
	T _____ R _____	_____
	T _____ R _____	_____
	T _____ R _____	_____
2. Property Controlling in Section	S _____ T _____ R _____	_____
	S _____ T _____ R _____	_____
3. Miscellaneous Property in Sec.	S _____ T _____ R _____	_____
	S _____ T _____ R _____	_____

MILDRED M. DODAK  
 REGISTER OF DEEDS  
 SAGINAW COUNTY MICH.

RECORDED & FILED

SEP 27 3 16 PM 1996

Register of Deeds Stamp & File Number

4. Lot No. \_\_\_\_\_, Recorded Plat \_\_\_\_\_

5. Private Claims \_\_\_\_\_

I, John H. Rauser, in a field survey on February 14, 1996, do hereby certify that under requirements of P.A. 74, Michigan P.A. of 1970, the corner points mentioned in lines 1 and 2 above were in conformance with regulations and rules therefore as required in the current manual of survey instructions of the United States Department of the Interior, Bureau of Land Management or by a decree of a Court of Law and/or that the corner points mentioned in lines 3, 4 and 5 above were in conformance with the rules of the Michigan Board of Land Surveyors or by a Decree of a Court of Law; established, re-established, monumented, re-monumented, recovered, found as expressed below:

1	A	B	C	D	E	F	G	H	I	J	K	L	M
2		6	5	4	3	2	1						
3													
4		7	8	9	10	11	12						
5													
6		18	17	16	15	14	13						
7													
8		19	20	21	22	23	24						
9													
10		30	29	28	27	26	25						
11													
12		31	32	33	34	35	36						
13													

NOTE: Not more than 4 corners, all in the same town and range, may be recorded on this certificate.

A. Description of original monument and accessories and/or subsequent restoration:

G-9 Section Corner 21, 22, 27, & 28, T9N-R3E

1839, Wood post placed by J. Mullet, D.S.  
 Beech 14" N85°E 19 lks. (12.54')  
 Beech 10" N76°W 43 lks. (28.38')  
 1974, Saginaw County Road Commission Records Fnd 3/4" pipe @ bit. surface  
 1976, Spicer Engineering field notes, Fnd 3/4" iron pipe in monument box  
 1983, Act 132 survey by J.S. Fokens, P.S. #21567 Rec. in L.1629, P.2049, Saginaw Co. Records

B. Description of corner evidence found and/or method applied in restoring or reestablishing corner:


G-9 Section Corner 21, 22, 27, & 28, T9N-R3E

Fnd no evidence of original government corner. Fnd 3/4" pipe in monument box, 3" below asphalt surface. Monument found is in agreement with records as stated in "A" above. Found no other information of record which disputes this position. Found monument is accepted as the best available evidence of the position of the original corner.

C. Description of monument for corner and accessories established to perpetuate locating the position of the corner:

G-9 Section Corner 21, 22, 27, & 28, T9N-R3E

Placed 5/8" Re-Rod w/"Saginaw County Monument" Brass Cap Stamped P.S.39096 in existing Monument Box  
 N50°W 39.00' Set EK w/tag 39096 S. fce. 4"x4" riser post  
 S30°E 102.18' Set EK w/tag 39096 S. fce P/P  
 S80°E 91.20' Chis. "+" E. end 12" CMP  
 N75°E 135.33' SW corner foundation house #17863

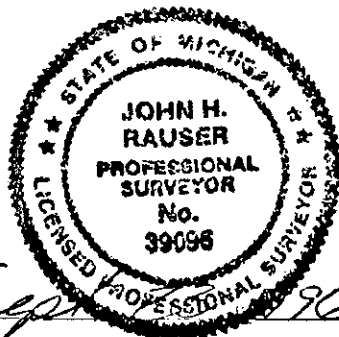

Signed by John H. Rauser Date Sept 1996

Surveyor's Michigan License No. 39096

MAY 16 1997