

SAGINAW COUNTY REMONUMENTATION

LAND CORNER RECORDATION CERTIFICATE
Filing Requirement of Act 74, Mich. P.A. 1970

For corners in

SAGINAW
(County)

Located in: **CHESANING TWP**
MAPLE GROVE TWP Corner Code #

1. Public Land Survey	T <u>9N</u> R <u>3E</u>	<u>M-13</u> ✓
	T <u>9N</u> R <u>4E</u>	<u>A-13</u>
2. Property Controlling in Section	S _____ T _____ R _____	_____
	S _____ T _____ R _____	_____
3. Miscellaneous Property in Sec.	S _____ T _____ R _____	_____
	S _____ T _____ R _____	_____

Line 7 Page 228


RECORDED/FILED
1998 OCT -5 A 9:54
MILDRED H. DODAK
REGISTER OF DEEDS
SAGINAW COUNTY, MI.

Register of Deeds Stamp & File Number

4. Lot No. _____, Recorded Plat _____
5. Private Claims _____

I, Brian D Ferguson, in a field survey on AUGUST 14, 1998 do hereby state that under requirements of P.A. 74, Michigan P.A. of 1970, the corner points mentioned in lines 1 and 2 above were in conformance with regulations and rules therefore as required in the current manual of survey instructions of the United States Department of the Interior, Bureau of Land Management or by a decree of a Court of Law and/or that the corner points mentioned in lines 3, 4 and 5 above were in conformance with the rules of the Michigan Board of Land Surveyors or by a Decree of a Court of Law; established, re-established, monumented, recovered, found as expressed below:

NOTE: Not more than 2 corners, all in the same town and range, may be recorded on this certificate.

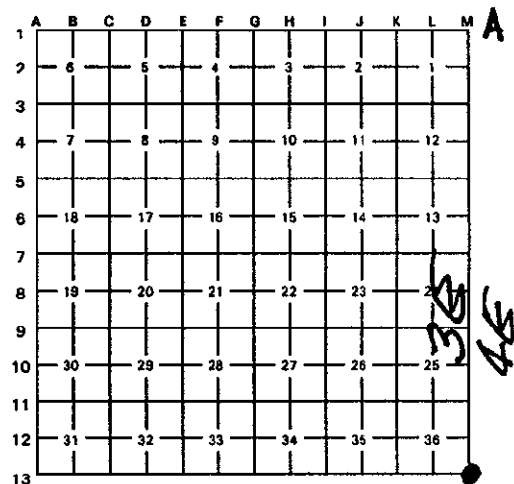

A. Description of original monument and accessories and/or subsequent restoration:

- M-13 WOOD POST SET BY JOHN MULLETT, DEPUTY SURVEYOR, IN 1831
A-13 18" ASH N89°E 35 LINKS
48" WHITE OAK S48°W 24 LINKS
LCRC BY LEACH IN 1973
LCRC BY PREVOST IN 1979
LCRC BY CALDWELL IN 1992 (RECORDED IN SHIAWASSEE COUNTY)
SURVEYS BY MISJAK & RAUSER

SURVEY &
REMONUMENTATION

MAR 12 1999

B. Description of corner evidence found and/or method applied in restoring or reestablishing corner:

SECTION

- M-13 FOUND 3/4" I.P. IN MONUMENT BOX
A-13 AGREES WITH LOCATION RECORDED IN LCRC'S AND SURVEYS

CORNER IS COMMON FOR T8 & 9N - R3 & 4E

ACCEPTED AS THE BEST AVAILABLE EVIDENCE OF THE POSITION OF THE ORIGINAL CORNER.

C. Description of monument for corner and accessories established to perpetuate locating the position of the corner:

- M-13 SET 5/8" STEEL BAR WITH 3" BRASS SAGINAW COUNTY REMONUMENTATION CAP IN MONUMENT BOX
A-13 N18°W 27.00' SET MAG. NAIL & SHINER IN W. EDGE PAVEMENT
WEST 9.87' PK NAIL W/TAG REI
EAST 26.05' NAIL & SHINER IN W FACE PWR POLE
N45°E 38.69' NAIL & SHINER TOP 14" CMP

Signed by Brian D Ferguson
Surveyor's Michigan License No. 26484

Date _____

