

APR 2 1999

APPROVED BY PEER GROUP
P.A. 345 OF 1990
SAGINAW COUNTY

SECTION
SAGINAW COUNTY REMONUMENTATION

LIBER 2084 PAGE 251

LAND CORNER RECORDATION CERTIFICATE
Filing Requirement of Act 74, Mich. P.A. 1970

For corners in

SAGINAW Located in: MAPLE GROVE TWP Corner Code #
(County)

- 1. Public Land Survey T 9N R 4E B-13
T R
- 2. Property Controlling in Section S T R
S T R
- 3. Miscellaneous Property in Sec. S T R
S T R

- 4. Lot No. _____, Recorded Plat _____
- 5. Private Claims _____

I, Brian D Ferguson, in a field survey on AUGUST 14, 1998 do hereby state that under requirements of P.A. 74, Michigan P.A. of 1970, the corner points mentioned in lines 1 and 2 above were in conformance with regulations and rules therefore as required in the current manual of survey instructions of the United States Department of the Interior, Bureau of Land Management or by a decree of a Court of Law and/or that the corner points mentioned in lines 3, 4 and 5 above were in conformance with the rules of the Michigan Board of Land Surveyors or by a Decree of a Court of Law; established, re-established, monumented, recovered, found as expressed below:

NOTE: Not more than 2 corners, all in the same town and range, may be recorded on this certificate.

A. Description of original monument and accessories and/or subsequent restoration:

- B-13 WOOD POST SET BY JOHN MULLETT, DEPUTY SURVEYOR, IN THE 1830'S
16" SYCAMORE N77°E 13 LINKS
14" SYCAMORE S71°W 18 LINKS
NO EVIDENCE OF ORIGINAL CORNER REMAINS
NO LCRC'S OR SURVEYS RECORDED FOR THIS CORNER

B. Description of corner evidence found and/or method applied in restoring or reestablishing corner:

- B-13 FOUND 3/4" PIPE W/CAP 24612
PIPE IS AT INTERSECTION OF FENCES RUNNING EAST, WEST AND NORTH


ACCEPTED AS THE BEST AVAILABLE EVIDENCE OF THE POSITION OF THE ORIGINAL CORNER.

C. Description of monument for corner and accessories established to perpetuate locating the position of the corner:

- B-13 SET 5/8" STEEL BAR WITH 3" BRASS SAGINAW COUNTY REMONUMENTATION CAP
N85°E 23.57' NAIL & SHINER S FACE 4" HICKORY
S55°E 18.98' NAIL & SHINER N FACE 10" ELM
N10°E 13.90' NAIL & SHINER N FACE 3" ELM
S85°W 8.43' NAIL & SHINER N FACE 10" HICKORY
N45°E 0.90' STEEL FENCE POST

Signed by Brian D Ferguson
Surveyor's Michigan License No. 26434

Date SEPTEMBER 29, 1998

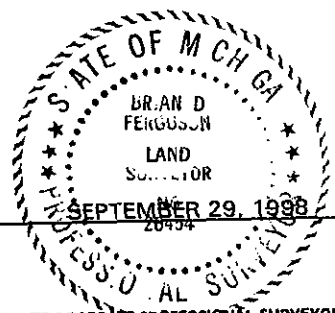

Lib 7 Page 229
1998 OCT -5 A 954
MILDRED M. DODD
REGISTER OF DEEDS
SAGINAW COUNTY, MI.
RECORDED/FILED
Register of Deeds Stamp & File Number

1	A	B	C	D	E	F	G	H	I	J	K	L	M
2	8		5		4		3		2				
3													
4	7		6		9		10		11		12		
5													
6	18		17		16		15		14		13		
7													
8	19		20		21		22		23		24		
9													
10	30		29		28		27		26		25		
11													
12	31		32		33		34		35		36		
13													