

MAR 12 1999

APPROVED BY PEER GROUP  
P.A. 345 OF 1990  
SAGINAW COUNTY

SECTION  
SAGINAW COUNTY REMONUMENTATION

LIBER 2084 PAGE 253

LAND CORNER RECORDATION CERTIFICATE  
Filing Requirement of Act 74, Mich. P.A. 1970

For corners in

SAGINAW Located in: MAPLE GROVE TWP Corner Code #  
(County)

- 1. Public Land Survey T 9N R 4E D-13  
T \_\_\_\_\_ R \_\_\_\_\_
- 2. Property Controlling S \_\_\_\_\_ T \_\_\_\_\_ R \_\_\_\_\_  
in Section S \_\_\_\_\_ T \_\_\_\_\_ R \_\_\_\_\_
- 3. Miscellaneous S \_\_\_\_\_ T \_\_\_\_\_ R \_\_\_\_\_  
Property in Sec. S \_\_\_\_\_ T \_\_\_\_\_ R \_\_\_\_\_

- 4. Lot No. \_\_\_\_\_, Recorded Plat \_\_\_\_\_
- 5. Private Claims \_\_\_\_\_

I, Brian D Ferguson, in a field survey on AUGUST 17, 19 98 do hereby state that under requirements of P.A. 74, Michigan P.A. of 1970, the corner points mentioned in lines 1 and 2 above were in conformance with regulations and rules therefore as required in the current manual of survey instructions of the United States Department of the Interior, Bureau of Land Management or by a decree of a Court of Law and/or that the corner points mentioned in lines 3, 4 and 5 above were in conformance with the rules of the Michigan Board of Land Surveyors or by a Decree of a Court of Law; established, re-established, monumented, recovered, found as expressed below:

NOTE: Not more than 2 corners, all in the same town and range, may be recorded on this certificate.

A. Description of original monument and accessories and/or subsequent restoration:

D-13 WOOD POST SET BY JOHN MULLETT IN 1840  
6" BEECH N80°E 15 LINKS  
17" BEECH S02°W 10 LINKS  
LCRC BY MATONICH IN 1986  
NO EVIDENCE OF ORIGINAL CORNER REMAINS

B. Description of corner evidence found and/or method applied in restoring or reestablishing corner:

D-13 FOUND 1/2" ROD W/CAP 11192 PER RECORDED LCRC  
NO OTHER RECORDED LCRC'S OR SURVEYS TO DISPUTE LOCATION OF CORNER  
LCRC S45°E, 51.89', 40d SPIKE NW FACE TWIN 8" ASPEN, MEASURED 51.90'  
LCRC S45°W, 33.77', 40d SPIKE NW FACE TWIN 8" ASPEN, MEASURED 33.65'


ACCEPTED AS THE BEST AVAILABLE EVIDENCE OF THE POSITION OF THE ORIGINAL CORNER.

C. Description of monument for corner and accessories established to perpetuate locating the position of the corner:

D-13 SET 5/8" STEEL BAR WITH 3" BRASS SAGINAW COUNTY REMONUMENTATION CAP  
S40°W 33.65' 40d SPIKE IN NW FACE 12" ELM  
S45°E 53.25' NAIL & SHINER W'LY FACE TWIN 8" ASPEN  
S45°E 51.90' 40d SPIKE NW FACE TWIN 8" ASPEN  
S60°E 68.78' 40d SPIKE W FACE 10" CLUMP ASPEN  
WEST 44.34' 1/2" ROD W/CAP 26454

Signed by Brian D Ferguson  
Surveyor's Michigan License No. 26454

Date \_\_\_\_\_

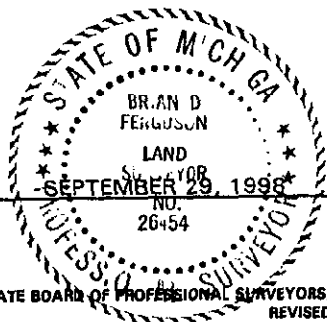

RECORDED/FILED  
1998 OCT -5 A 9:54  
MILDRED M. DODAK  
REGISTER OF DEEDS  
SAGINAW COUNTY, MI.  
*Liber 7 Page 231*  
Register of Deeds Stamp & File Number

	A	B	C	D	E	F	G	H	I	J	K	L	M
1													
2	8		6		4		3		2		1		
3													
4	7		8		9		10		11		12		
5													
6	18		17		16		15		14		13		
7													
8	19		20		21		22		23		24		
9													
10	30		29		28		27		26		25		
11													
12	31		32		33		34		35		36		
13													