

**SAGINAW COUNTY REMONUMENTATION 1998  
LAND CORNER RECORDATION CERTIFICATE  
Filing Requirement of Act 74, Mich. P.A. 1970**

LIBER **2084** PAGE **827**

For corners in

<u>Saginaw</u> (County)	Located In: <u>Maple Grove Twp</u>	Corner Code # <u>G-13</u>
1. Public Land Survey	T <u>9 N</u> R <u>4 E</u>	<u>G-13</u>
	T _____ R _____	_____
	T _____ R _____	_____
	T _____ R _____	_____
2. Property Controlling in Section	S _____ T _____	_____
	S _____ T _____	_____
3. Miscellaneous Property in Sec.	S _____ T _____	_____
	S _____ T _____	_____

**RECORDED/FILED**  
 1998 OCT -6 A 9:08  
 MILDRED M. DODAK  
 REGISTER OF DEEDS  
 SAGINAW COUNTY, MI.  
*Liber 7 Page 233*  
 Register of Deeds Stamp & File Number

4. Lot No. \_\_\_\_\_, Recorded Plat \_\_\_\_\_  
 5. Private Claims \_\_\_\_\_

I, Ronald C. Prevost, in a field survey on 7-15, 1998 do hereby state that under requirements of P.A. 74, Michigan P.A. of 1970, the corner points mentioned in lines 1 and 2 above were in conformance with regulations and rules therefore as required in the current manual of survey instructions of the United States Department of the Interior, Bureau of Land Management or by a decree of a Court of Law and for that the corner points mentioned in lines 3, 4 and 5 above were in conformance with the rules of the Michigan Board of Land Surveyors or by a Decree of a Court of Law; established, re-established, monumented, recovered, found as expressed below:

1	A	B	C	D	E	F	G	H	I	J	K	L	M
2		6		5		4		3		2		1	
3													
4		7		8		9		10		11		12	
5													
6		18		17		16		15		14		13	
7													
8		19		20		21		22		23		24	
9													
10		30		29		28		27		26		25	
11													
12		31		32		33		34		35		36	
13													

**NOTE:** Not more than 2 corners, all in the same town and range, may be recorded on this certificate.

A. Description of original monument and accessories and/or subsequent restoration:

G-13 Post set by D.S. Joseph Wampler 1822±.  
 Beech 8" N.56°E. 5 L.  
 Sugar 7" S.32°E. 7 L.  
 Ref. By Co. Surveyor Goudalis, 1888, stone, crockery & tile.  
 LCRC L7, P6 L1941, P1532 J. Rauser #39096, 1995 established corner.


**APPROVED BY PEER GROUP  
 P.A. 345 OF 1990  
 SAGINAW COUNTY**  
*[Signature]* 7-29-98

B. Description of corner evidence found and/or method applied in restoring or reestablishing corner:

G-13 Found 1/2" rod & cap #39096 in mon box.  
 Note: This L.C.R.C. L7, P6 & L1941, P1532 by John Rauser offers a detailed description of the determination of this corner G-13. Proportional between H-13 & E-13. This witness from John Rauser's L.C.R.C. check out with the exception of a P. pole to SW which has been replaced, See Section C.  
 Accepted as the best available evidence of the position of the original corner.

C. Description of monument for corner and accessories established to perpetuate locating the position of the corner:

G-13 Replaced 1/2" rod with 5/8" bar with Saginaw Co. re-mon cap in existing mon box 9-16-98.  
 West 11.22 1/2" bar & cap, closing corner Sections 3 & 4, T.8 N.-R.4 E.  
 East 11.66 3/4" pipe in M.B. erroneous corner.  
 S.50°E. 32.65 chisled + in top ctr concr. hdwl (32.65M).  
 N.55°E. 54.07 P.K. nail in W face T. pole guard post (54.07M).  
 S.47°W.24.00 punch hole in top center C.M.P. (24.00M).  
 S.50°W.84.76 set mag nail in SE face P. pole (new wit in new pole).

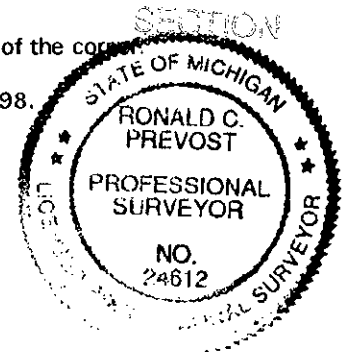

Signed by Ronald C. Prevost  
 Ronald C. Prevost  
 Surveyor's Michigan License No. 24612

Date 9-21-98