

**SAGINAW COUNTY REMONUMENTATION 1998
LAND CORNER RECORDATION CERTIFICATE
Filing Requirement of Act 74, Mich. P.A. 1970**

LIBER **2084** PAGE **831**

For corners in

<u>Saginaw</u> (County)	Located In: Maple Grove Twp	Corner Code # _____
1. Public Land Survey	T <u>9 N</u> R <u>4 E</u>	<u>J-13</u>
	T _____ R _____	_____
	T _____ R _____	_____
	T _____ R _____	_____
2. Property Controlling in Section	S _____ T _____ R _____	_____
	S _____ T _____ R _____	_____
3. Miscellaneous Property in Sec.	S _____ T _____ R _____	_____
	S _____ T _____ R _____	_____

1998 OCT -6 A 9:08
HILDED M. DODAK
REGISTER OF DEEDS
SAGINAW COUNTY, MI.
Liber 7 Page 237
RECORDED/FILED
Register of Deeds Stamp & File Number

4. Lot No. _____, Recorded Plat _____
5. Private Claims _____

I, Ronald C. Prevost, in a field survey on 7-15, 1998 do hereby state that under requirements of P.A. 74, Michigan P.A. of 1970, the corner points mentioned in lines 1 and 2 above were in conformance with regulations and rules therefore as required in the current manual of survey instructions of the United States Department of the Interior, Bureau of Land Management or by a decree of a Court of Law and /or that the corner points mentioned in lines 3, 4 and 5 above were in conformance with the rules of the Michigan Board of Land Surveyors or by a Decree of a Court of Law; established, re-established, monumented, recovered, found as expressed below:

	A	B	C	D	E	F	G	H	I	J	K	L
1												
2	6			5		4		3		2		
3												
4	7			8		9		10		11		
5												
6	18			17		16		15		14		
7												
8	19			20		21		22		23		24
9												
10	30			29		28		27		26		
11												
12	31			32		33		34		35		
13												

NOTE: Not more than 2 corners, all in the same town and range, may be recorded on this certificate.

A. Description of original monument and accessories and/or subsequent restoration:

J-13 Post set by Joseph Wampler D.S. 1822±.
Ash 30" S.68"E. 4 L.
Beech 9" N.69"W. 3 1/2 L.
Spicer Eng. notes 1994, found bent T-iron replaced with 3/4" pipe.
L.C.R.C. L1903, P2174, Prevost #24612, 1994 fnd bent T-iron replaced with 3/4" pipe.

APPROVED BY PEER GROUP
P.A. 345 OF 1990
SAGINAW COUNTY
BDX 7-29-98

B. Description of corner evidence found and/or method applied in restoring or reestablishing corner:


J-13 Found 3/4" pipe 0.5' below gravel.
From L.1903, P.2174 & Spicer notes S.85"E 89.20 ctr mail box post auger (89.18M)
From L.1903, P.2174 & Spicer notes North 33.00 3/4" pipe (33.00M)
From L.1903, P.2174 & Spicer notes on N. edge Gravel Rd (ok).

SURVEY &
REVISION SECTION
MAR 12 1999
SECTION

Accepted as the best available evidence of the position of the original corner.

C. Description of monument for corner and accessories established to perpetuate locating the position of the corner:

J-13 Replaced 3/4" pipe with 5/8" rod with Saginaw Co. re-mon cap 6" below gravel 9-16-98.
North 33.00 3/4" pipe w/cap #24612.
S.85"E 89.18 center mail box post (old auger).
S.W. 152.48 set nail NW face P. pole.
West 13.92 1/2" re-bar w/cap #24622 N 1/4 cor Sec. 2, T.8 N.-R.4 E.

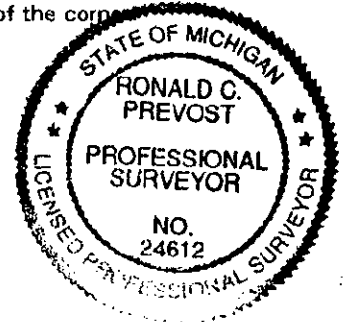

Signed by Ronald C. Prevost
Ronald C. Prevost

Date 9-21-98

Surveyor's Michigan License No. 24612