

REMONUMENTATION  
 RECONSTRUCTION  
 MAR 17 1999

**SAGINAW COUNTY REMONUMENTATION 1998**  
**SECTION LAND CORNER RECORDATION CERTIFICATE**  
**Filing Requirement of Act 74, Mich. P.A. 1970**

LIBEL 2084 PAGE 840

or corners in

Saginaw (County)	Located In: Maple Grove Twp	Corner Code #
Public Land Survey	T <u>9 N</u> R <u>4 E</u>	<u>M-5</u>
	T _____ R _____	_____
	T _____ R _____	_____
	T _____ R _____	_____
Property Controlling in Section	S _____ T _____ R _____	_____
Miscellaneous Property in Sec.	S _____ T _____ R _____	_____

1998 OCT -6 A 9:08  
 MILFRED M. DODAK  
 REGISTER OF DEEDS  
 SAGINAW COUNTY, MI.  
 RECORDED/FILED

*Libel 7 Page 246*

Register of Deeds Stamp & File Number

Lot No. \_\_\_\_\_, Recorded Plat \_\_\_\_\_  
 Private Claims \_\_\_\_\_

Ronald C. Prevost, in a field survey on 7-23, 1998 do hereby state that under requirements of P.A. 74, Michigan P.A. of 1970, the corner points mentioned in lines 1 and 2 above were in conformance with regulations and rules therefore as required in the current manual of survey instructions of the United States Department of the Interior, Bureau of Land Management or by a decree of a Court of Law and /or that the corner points mentioned in lines 3, 4 and 5 above were in conformance with the rules of the Michigan Board of Land and Surveyors or by a Decree of a Court of Law; established, re-established, monumented, discovered, found as expressed below:

	A	B	C	D	E	F	G	H	I	J	K	L	N
1													
2	6		5		4		3		2				
3													
4	7		8		9		10		11		1		
5													
6	16		17		16		15		14		1		
7													
8	19		20		21		22		23		24		
9													
10	30		29		28		27		26		25		
11													
12	31		32		33		34		35				
13													

NOTE: Not more than 2 corners, all in the same town and range, may be recorded on this certificate.

A. Description of original monument and accessories and/or subsequent restoration:

M-5 Post set by D.S. Joseph Wampler 1822±.  
 Ash 6" S.12°E. 18 L.  
 W. Oak 13" N.49°W. 20 L.  
 Shown on M.D.O.T. R/W maps 1937±.  
 L.C.R.C. L2, P243 J. Martin 1974 mon box with 5/8" rod.  
 Spicer Eng. Notes 1973 used in survey and recorded L2, P243.

APPROVED BY PEER GROUP  
 P.A. 345 OF 1990  
 SAGINAW COUNTY

*RDF 8-5-98*


B. Description of corner evidence found and/or method applied in restoring or reestablishing corner:

M-5 Found 3/4" pipe in mon/box.  
 N.53°W 68.80 nail & tag #39096 in top old tel pole. (68.83R L2, P243).

Accepted as the best available evidence of the position of the original corner.

C. Description of monument for corner and accessories established to perpetuate locating the position of the corner:

M-5 Placed Saginaw Co Re-mon cap on 5/8" bar in place of 3/4" pipe in existing mon box. 9/23/98  
 N.60°E. 49.80 ctr. st. sign post.  
 N.83°E. 45.13 NW cor N headwall for culvert.  
 S.63°E. 45.55 SW cor S headwall for culvert.  
 S.51°W 89.03 set nail & flagging NW face P. pole.  
 N.53°W. 68.80 nail & tag #39096 in top old T pole.

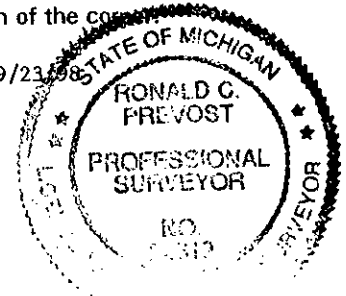

Signed by Ronald C. Prevost

Date 9-25-98

Ronald C. Prevost

Surveyor's Michigan License No. 24612