

**SAGINAW COUNTY REMONUMENTATION 1998
LAND CORNER RECORDATION CERTIFICATE
Filing Requirement of Act 74, Mich. P.A. 1970**

corners in

LIBER **2084** PAGE **839**

Liber 7 Page 245

<u>Saginaw</u> (County)	Located In: Maple Grove Twp	Corner Code #
Public Land Survey	T <u>9 N</u> R <u>4 E</u>	<u>M-6</u>
	T _____ R _____	_____
	T _____ R _____	_____
	T _____ R _____	_____
Property Controlling in Section	S _____ T _____ R _____	_____
Miscellaneous	S _____ T _____ R _____	_____
Property in Sec.	S _____ T _____ R _____	_____

1998 OCT -6 A 9:00
MILFRED M. DODAK
REGISTER OF DEEDS
SAGINAW COUNTY
RECORDED/FILED
Register of Deeds Stamp & File Number

Lot No. _____, Recorded Plat _____
Private Claims _____

1	A	B	C	D	E	F	G	H	I	J	K	L	M
2	6		5		4		3		2		1		
3													
4	7		8		9		10		11				
5													
6	18		17		16		15		14		13		
7													
8	19		20		21		22		23		24		
9													
10	30		29		28		27		26		25		
11													
12	31		32		33		34		35		36		
13													

Ronald C. Prevost, in a field survey on 7-23, 1998 do hereby state that under requirements of P.A. 74, Michigan P.A. of 1970, the corner points mentioned in lines 1 and 2 above were in conformance with regulations and rules therefore as required in the current manual of survey instructions of the United States Department of the Interior, Bureau of Land Management or by a decree of a Court of Law and /or that the corner points mentioned in lines 3, 4 and 5 above were in conformance with the rules of the Michigan Board of Land Surveyors or by a decree of a Court of Law; established, re-established, monumented, recovered, found as expressed below:

NOTE: Not more than 2 corners, all in the same town and range, may be recorded on this certificate.


A. Description of original monument and accessories and/or subsequent restoration:
M-6 Post set by D.S. Joseph Wampler 1822±.
Beech 6" S.50°W. 3 1/2 L.
Beech 15" N.42°E. 17 L.
Shown on M.D.O.T. r/w plans 1937±.
P.K. nail & tag set by John Rauser, P.S. #39096 Rowe Eng. while surveying in NE 1/4, Section 13, T.9 N.-R.4 E., 1994 recorded survey L1920, P1811-14.

APPROVED BY PEER GROUP
P.A. 345 OF 1990
SAGINAW COUNTY
BOJ 8-5-98

B. Description of corner evidence found and/or method applied in restoring or reestablishing corner:
M-6 P.K. nail & tag set by John Rauser L1920, P1811-14 as mentioned above.
Was paved over recently, established location 3.28 feet North of W 1/4 cor.
Section 18, T.9 N.-R.5 E., and on line with said 1/4 corner and cor M-7 T.9 N.-R.4 E.
Accepted as the best available evidence of the position of the original corner.

SURVEY &
REMONUMENTATION
MAR 12 1999
SECTION

C. Description of monument for corner and accessories established to perpetuate locating the position of the corner:
M-6 Placed 5/8" rod, Saginaw County remon cap and mon box at P.K. position as mentioned above. 9/23/98.
West 61.87 re rod w/cap #39096.
South 3.28 3/8" rod in mon box W.1/4 cor. Sec. 18, T.9 N.-R.5 E.
N.24°E. 71.31 MSHD tag W. face 39" Oak.
N.87°E. 57.28 spike w/tag #39096 S. face 6" Elm.

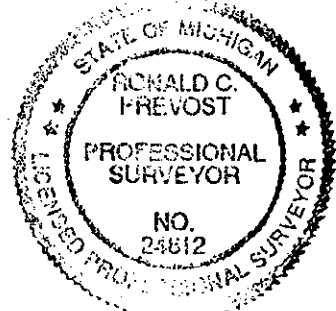

Signed by Ronald C. Prevost
Ronald C. Prevost
Surveyor's Michigan License No. 24612

Date 9-25-98