

**SAGINAW COUNTY REMONUMENTATION 1998  
LAND CORNER RECORDATION CERTIFICATE  
Filing Requirement of Act 74, Mich. P.A. 1970**

LIBER 2084 PAGE 834

For corners in

<u>Saginaw</u> (County)	Located In: <u>Maple Grove Twp</u>	Corner Code #
1. Public Land Survey	T <u>9 N</u> R <u>4 E</u>	<u>M-9</u>
	T _____ R _____	_____
	T _____ R _____	_____
	T _____ R _____	_____
2. Property Controlling in Section	S _____ T _____ R _____	_____
	S _____ T _____ R _____	_____
3. Miscellaneous Property in Sec.	S _____ T _____ R _____	_____

1998 OCT -6 A 9:08  
MILDRED M. DODAK  
REGISTER OF DEEDS  
SAGINAW COUNTY, MI.  
*Liber 7 Page 240*  
RECORDED/FILED  
Register of Deeds Stamp & File Number

4. Lot No. \_\_\_\_\_, Recorded Plat \_\_\_\_\_  
5. Private Claims \_\_\_\_\_

Ronald C. Prevost, in a field survey on 7-23, 1998 do hereby state that under requirements of P.A. 74, Michigan P.A. of 1970, the corner points mentioned in lines 1 and 2 above were in conformance with regulations and rules therefore as required in the current manual of survey instructions of the United States Department of the Interior, Bureau of Land Management or by a decree of a Court of Law and for that the corner points mentioned in lines 3, 4 and 5 above were in conformance with the rules of the Michigan Board of Land Surveyors or by a Decree of a Court of Law; established, re-established, monumented, recovered, found as expressed below:

A	B	C	D	E	F	G	H	I	J	K	L	M
1												
2	6	5	4	3	2							
3												
4	7	8	9	10	11							
5												
6	16	17	16	15	14	13						
7												
8	19	20	21	22	23	24						
9												
10	30	29	28	27	26	25						
11												
12	31	32	33	34	35							
13												

NOTE: Not more than 2 corners, all in the same town and range, may be recorded on this certificate.

A. Description of original monument and accessories and/or subsequent restoration:

M-9 Corner to Sections 24 & 25 is a Beech 5" Joseph Wampler D.S. 1822±. Beech 12" S.70°W. 3 1/2 L. Shown on M.D.O.T. r/w plans 1937± 13.13 S. of closing corner A-9 T.9 N.-R.5 E. Act 132 L1364, P9-10 David Rowe 1972 mon bpx. Act 132 L1473, P674 J. Fulkens 1976 + on mon box cover. Act 132 L1597, P2039 J. Fulkens 1981 + on mon box cover.

APPROVED BY PEER GROUP  
P.A. 345 OF 1990  
SAGINAW COUNTY  
*BD 7-29-98*

B. Description of corner evidence found and/or method applied in restoring or reestablishing corner:


M-9 Found 1" pipe with 1/2" pipe inside in mon box 9-17-98. From Act 132 L1364, P9-10 P.K. nail in pole N.65°W. 64.84 (64.75 R.L.S. tag #11192 S face T. pole) From Act 132 L1364, P9-10 NW cor Sec 30 North 13.09 (13.23M 2" Pipe/MB) From Act 132 L1473, P674 N.60°W. 64.85 MSHD tag in T.P. (64.85M) From Act 132 L1473, P674 S.75°E. 65.31 R.L.S. #11192 tag in T. P.(65.30M)

SAGINAW COUNTY  
REMONUMENTATION  
SEP 18 1999  
SECTION

Accepted as the best available evidence of the position of the original corner.

C. Description of monument for corner and accessories established to perpetuate locating the position of the corner:

M-9 Replaced 1" pipe with 5/8" rod Saginaw Co. re-mon cap in existing mon box 9-17-98. S.65°E. 65.30 R.L.S. #11192 tag W face T. pole. N.55°W. 64.75 R.L.S. #11192 tag S face T. pole. N.55°W. 64.85 MSHD #11192 tag N face T. pole. S.55°W .91.10 NE cor. foundation Hse #10519 North 13.23 2" pipe/mon box A-9 T.9 N.-R.5 E. East 3.43 const'n 4. M-13.

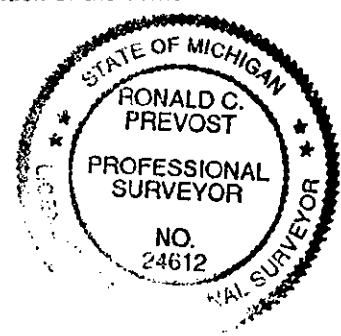

Signed by Ronald C. Prevost  
Ronald C. Prevost  
Surveyor's Michigan License No. 24612

Date 9-21-98