

**SAGINAW COUNTY REMONUMENTATION 1998
LAND CORNER RECORDATION CERTIFICATE
Filing Requirement of Act 74, Mich. P.A. 1970**

for corners in

LIBER 2084 PAGE 835

Saginaw (County)	Located In: Maple Grove Twp	Corner Code #
1. Public Land Survey	T <u>9 N</u> R <u>4 E</u>	<u>M-10</u>
	T _____ R _____	_____
	T _____ R _____	_____
	T _____ R _____	_____
2. Property Controlling in Section	S _____ T _____ R _____	_____
	S _____ T _____ R _____	_____
3. Miscellaneous Property in Sec.	S _____ T _____ R _____	_____
	S _____ T _____ R _____	_____

RECORDED/FILED
1998 OCT -6 A 9:08
MILDRED M. DODAK
REGISTER OF DEEDS
SAGINAW COUNTY, MI.
Liber 7 Page 241
Register of Deeds Stamp & File Number

4. Lot No. _____, Recorded Plat _____
5. Private Claims _____

Ronald C. Prevost, in a field survey on 7-23, 1998 do hereby state that under requirements of P.A. 74, Michigan P.A. of 1970, the corner points mentioned in lines 1 and 2 above were in conformance with regulations and rules therefore as required in the current manual of survey instructions of the United States Department of the Interior, Bureau of Land Management or by a decree of a Court of Law and /or that the corner points mentioned in lines 3, 4 and 5 above were in conformance with the rules of the Michigan Board of Land Surveyors or by a Decree of a Court of Law; established, re-established, monumented, recovered, found as expressed below:

	A	B	C	D	E	F	G	H	I	J	K	L	M
1													
2	6			5		4		3		2			
3													
4	7			8		9		10		11			
5													
6	16			17		16		15		14			
7													
8	19			20		21		22		23			
9													
10	30			29		28		27		26			
11													
12	31			32		33		34		35			
13													

NOTE: Not more than 2 corners, all in the same town and range, may be recorded on this certificate.

A. Description of original monument and accessories and/or subsequent restoration:

M-10 Post set by D.S. Joseph Wampler 1822±.
Elm 18" N.71°E. 10 L.
Sugar 6 N.70°W.10 L. *
Approximate location shown on M.D.O.T. r/w plans.
L.C.R.C. L5, P56 J. Fulkens 1979 P.K. set at split of mile.
P.A 132 L1597, P2038-9 J. Fulkens 1981 set conc. nail at split of mile.
P.A.132 L1622, P2296 J. Fulkens 1988 fnd conc. nail at split of mile.

APPROVED BY PEER GROUP
P.A. 345 OF 1990
SAGINAW COUNTY
BDP 7-29-98

B. Description of corner evidence found and/or method applied in restoring or reestablishing corner:


M-10 Found shank of P.K. or conc. nail 0.2 below bit.
From LCRC L5, P56 witnesses seem to be for some other location.
From Act 132 L1597, P2038-9 N.50°W. 28.72 P.K. w/flag top guard rail post.(28.72M).
From Act 132 L1597, P2038-9 N.30°E. 32.88 P.K. w/flag top guard rail post. (32.88M).
From Act 132 L1597, P2038-9 S.25°E. 41.25 P.K. w/flag top guard rail post. (41.25M).
From Act 132 L1622, P2296 witnesses same as L159, P2038-9.

SURVEY &
REMONUMENTATION
MAR 12 1999
SECTION

Accepted as the best available evidence of the position of the original corner.

C. Description of monument for corner and accessories established to perpetuate locating the position of the corner:

M-10 Placed mon box 5/8" rod with Saginaw Co. re-mon cap at nail shank location 9-17-98.
N.40°W. 28.72 P.K. w/flag in guard rail post.
N.65°E. 32.88 P.K. w/flag in guard rail post.
S.25°E. 41.25 P.K. w/flag in guard rail post.
S.75°E. 24.32 spike & flag in top guard rail post.
S.57°W. 27.29 spike & flag in top guard rail post.
N.50°W. 24.92 spike & flag in top guard rail post.
East 1.50 f. const. M-13.

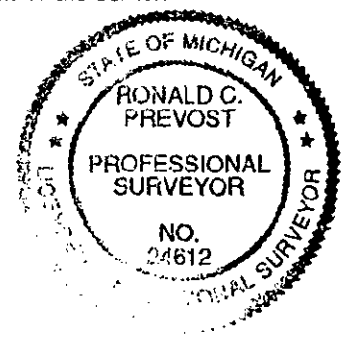

Signed by Ronald C. Prevost
Ronald C. Prevost

Date 9-21-98

Surveyor's Michigan License No. 24612