

**SAGINAW COUNTY REMONUMENTATION 1998
LAND CORNER RECORDATION CERTIFICATE
Filing Requirement of Act 74, Mich. P.A. 1970**

Liber 7 Page 242

For corners in

LIBER 2084 PAGE 836

| Saginaw (County) | | Located In: Maple Grove Twp | Corner Code # |
|------------------------------------|---|--------------------------------|---------------|
| 1. Public Land Survey | T | <u>9 N</u> R <u>4 E</u> | <u>M-11</u> |
| | T | _____ R _____ | _____ |
| | T | _____ R _____ | _____ |
| | T | _____ R _____ | _____ |
| 2. Property Controlling in Section | S | _____ T _____ | _____ |
| | S | _____ T _____ | _____ |
| 3. Miscellaneous Property in Sec. | S | _____ T _____ | _____ |
| | S | _____ T _____ | _____ |

1998 OCT -6 A 9:08
MILDRED M. DODAK
REGISTER OF DEEDS
SAGINAW COUNTY, MI.
RECORDED/FILED
Register of Deeds Stamp & File Number

4. Lot No. _____, Recorded Plat _____
5. Private Claims _____

I, Ronald C. Prevost, in a field survey on 7-21, 1998 do hereby state that under requirements of P.A. 74, Michigan P.A. of 1970, the corner points mentioned in lines 1 and 2 above were in conformance with regulations and rules therefore as required in the current manual of survey instructions of the United States Department of the Interior, Bureau of Land Management or by a decree of a Court of Law and for that the corner points mentioned in lines 3, 4 and 5 above were in conformance with the rules of the Michigan Board of Land Surveyors or by a Decree of a Court of Law; established, re-established, monumented, recovered, found as expressed below:

| | | | | | | | | | | | | |
|----|----|---|----|---|----|---|----|---|----|---|----|---|
| A | B | C | D | E | F | G | H | I | J | K | L | M |
| 1 | | | | | | | | | | | | |
| 2 | 6 | | 5 | | 4 | | 3 | | 2 | | 1 | |
| 3 | | | | | | | | | | | | |
| 4 | 7 | | 8 | | 9 | | 10 | | 11 | | | |
| 5 | | | | | | | | | | | | |
| 6 | 18 | | 17 | | 16 | | 15 | | 14 | | 13 | |
| 7 | | | | | | | | | | | | |
| 8 | 19 | | 20 | | 21 | | 22 | | 23 | | 24 | |
| 9 | | | | | | | | | | | | |
| 10 | 30 | | 29 | | 28 | | 27 | | 26 | | 25 | |
| 11 | | | | | | | | | | | | |
| 12 | 31 | | 32 | | 33 | | 34 | | 35 | | 36 | |
| 13 | | | | | | | | | | | | |

NOTE: Not more than 2 corners, all in the same town and range, may be recorded on this certificate.

A. Description of original monument and accessories and/or subsequent restoration:

M-11 Post set by D.S. Joseph Wampler 1822 ±.
Beech 14" S.42°E. 12 L.
Elm 6" N.43° W. 8 L.
Shown on M.D.O.T. r/w plans 1937 ±.
Act 132 L1364, P9-10 Rowe Eng #11192 1972 MB.
Act 132 L1473, P674 Folkens #21567 1976 MB.
Act 132 L1638, P1154 Vanraembonck #26422 1984 iron pin in MB.
LCRC L1638, P1157 Vanraembonck #24622 1984 iron pin in MB.

APPROVED BY PEER GROUP
P.A. 345 OF 1990
SAGINAW COUNTY
RDP 7-29-98

B. Description of corner evidence found and/or method applied in restoring or reestablishing corner:


M-11 Found 1" iron pin in mon box.
From L1364, P9-10 x in r/w marker S.75°E. 68.37 (marker now broken but wit. ok).
From L1364, P9-10 x in r/w marker SW cor. Sec 30 North 7.75 (7.90M).
From L1473, P674 same witnesses as L1364, P9-10.
From L1638, P1154 N. 7.80 mon box (7.90M).
From L1638, P1154 S.75°E. 68.37 x on top conc r/w marker (marker now broken wit ok+).
From L1638, P1154 S.30°W. 53.0 top ctr 18" conc. culvert (52.73M).
From LCRC L1638, P1154 same witnesses as L1638, P1154.

SURVEY & REMONUMENTATION
MAR 12 1999
SECTION

Accepted as the best available evidence of the position of the original corner.

C. Description of monument for corner and accessories established to perpetuate locating the position of the corner:

M-11 Placed 5/8" pin and Saginaw Co re-mon cap in position of iron pin in existing mon box 9-16-98
N.58°E. 105.60 SW cor. brick house.
S.30°W. 52.73 top center 18" conc. culvert.
N.60°W. 69.53 center tel pedestal.
North 7.90 A-11 T.9N.-R.5 E. mon box.

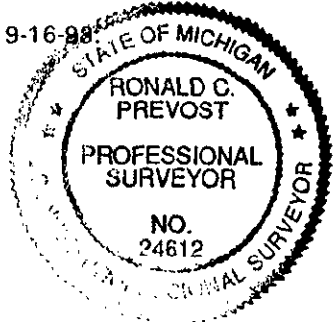

Signed by Ronald C. Prevost
Ronald C. Prevost

Date 9-21-98

Surveyor's Michigan License No. 24612