

**SAGINAW COUNTY REMONUMENTATION 1998  
LAND CORNER RECORDATION CERTIFICATE  
Filing Requirement of Act 74, Mich. P.A. 1970**

LIBER **2084** PAGE **832**

For corners in

<u>Saginaw</u> (County)	Located In: <b>Maple Grove Twp</b>	Corner Code #
1. Public Land Survey	T <u>9 N</u> R <u>4 E</u>	<u>M-13</u>
	T _____ R _____	_____
	T _____ R _____	_____
	T _____ R _____	_____
2. Property Controlling in Section	S _____ T _____ R _____	_____
	S _____ T _____ R _____	_____
3. Miscellaneous Property in Sec.	S _____ T _____ R _____	_____
	S _____ T _____ R _____	_____

1998 OCT - 6 A 9:08  
MILDRED H. DODAK  
REGISTER OF DEEDS  
SAGINAW COUNTY, MI.  
*Lib 7 Page 238*  
RECORDED/FILED  
Register of Deeds Stamp & File Number

4. Lot No. \_\_\_\_\_, Recorded Plat \_\_\_\_\_  
5. Private Claims \_\_\_\_\_

I, Ronald C. Prevost, in a field survey on 7-21, 1998 do hereby state that under requirements of P.A. 74, Michigan P.A. of 1970, the corner points mentioned in lines 1 and 2 above were in conformance with regulations and rules therefore as required in the current manual of survey instructions of the United States Department of the Interior, Bureau of Land Management or by a decree of a Court of Law and /or that the corner points mentioned in lines 3, 4 and 5 above were in conformance with the rules of the Michigan Board of Land Surveyors or by a Decree of a Court of Law; established, re-established, monumented, recovered, found as expressed below:

A	B	C	D	E	F	G	H	I	J	K	L	M
1												
2	6		5		4		3		2			
3												
4	7		8		9		10		11			
5												
6	18		17		16		15		14			
7												
8	19		20		21		22		23			
9												
10	30		29		28		27		26			
11												
12	31		32		33		34		35			
13												

NOTE: Not more than 2 corners, all in the same town and range, may be recorded on this certificate.

A. Description of original monument and accessories and/or subsequent restoration:

M-13 Post established by Deputy Surveyors 1822± Town corner.  
Shown on M.D.O.T. r/w plans 1937±.  
L.C.R.C L3 P56, Piotrowski #9685 mon box, 1974.

APPROVED BY PEER GROUP  
P.A. 345 OF 1990  
SAGINAW COUNTY

*RD* 7-29-98

B. Description of corner evidence found and/or method applied in restoring or reestablishing corner:


M-13 Found R.R. spike in mon box.  
From L3 P56 anchor post N.55°E. 65.40 (65.42M).  
Distance North to corner M-12 = 2638.69 (r/w maps 2638.4).

Accepted as the best available evidence of the position of the original corner.

SECTION  
SEP 2 1998

C. Description of monument for corner and accessories established to perpetuate locating the position of the corner:

M-13 Replaced R.R. spike in existing mon box with 5/8" rod & Saginaw Co. re-mon cap 9-16-98.  
N.72 E. 65.42 anchor post.  
East 0.90' const'n M-13.  
N.55' W. 69.85 chisled X on top center hwy r/w marker.  
N.22' W 166.27 set nail NE face P. pole.  
S.55°E. 67.06 steel anchor post.

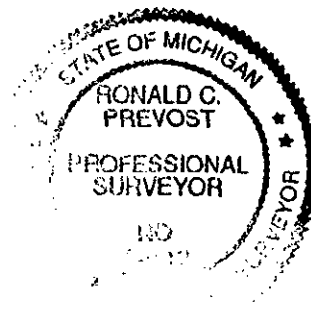

Signed by Ronald C. Prevost  
Ronald C. Prevost

Date 9-21-98

Surveyor's Michigan License No. 24612