

APPROVED BY PEER GROUP  
P.A. 345 OF 1990  
SAGINAW COUNTY

SAGINAW COUNTY REMONUMENTATION

RECORDED/FILED

LAND CORNER RECORDATION CERTIFICATE  
Filing Requirement of Act 74, Mich. P.A. 1970

1997 SEP 26 P 3: 28

For corners in

SAGINAW Located in: B'RUN TWP. Corner Code #  
(County)

1. Public Land Survey T 10N R 6E H-13  
T     R    

2. Property Controlling S     T     R      
in Section S     T     R    

3. Miscellaneous S     T     R      
Property in Sec. S     T     R    

MILDRED M. DODAK  
REGISTER OF DEEDS  
SAGINAW COUNTY, MI.

LIBER 2027 PAGE 460

*Liber 7 Page 151*  
Register of Deeds Stamp & File Number

4. Lot No. \_\_\_\_\_, Recorded Plat \_\_\_\_\_  
5. Private Claims \_\_\_\_\_

I, BRIAN D FERGUSON, in a field survey on JUNE 17, 19 97 do hereby state that under requirements of P.A. 74, Michigan P.A. of 1970, the corner points mentioned in lines 1 and 2 above were in conformance with regulations and rules therefore as required in the current manual of survey instructions of the United States Department of the Interior, Bureau of Land Management or by a decree of a Court of Law and/or that the corner points mentioned in lines 3, 4 and 5 above were in conformance with the rules of the Michigan Board of Land Surveyors or by a Decree of a Court of Law; established, re-established, monumented, recovered, found as expressed below:

NOTE: Not more than 2 corners, all in the same town and range, may be recorded on this certificate.

A. Description of original monument and accessories and/or subsequent restoration:

H-13: WOOD POST SET BY WAMPLER IN 1822  
SURVEY &  
REMONUMENTATION

MAR 18 1998

SECTION

APPROVED BY PEER GROUP  
P.A. 345 OF 1990  
SAGINAW COUNTY

9-18-97 *[Signature]*


B. Description of corner evidence found and/or method applied in restoring or reestablishing corner:

H-13: FOUND 3/4" IRON PIPE  
LCRC RECORDED IN L 2 PG 127  
SURVEYS RECORDED IN L 1376 PG 206, L 1605 PG 2281, L 1513 PG 100

ACCEPTED BY THE PEER REVIEW GROUP AS THE BEST  
AVAILABLE EVIDENCE OF THE POSITION OF THE ORIGINAL CORNER

C. Description of monument for corner and accessories established to perpetuate locating the position of the corner:

H-13: SET 5/8" ROD W/3" BRASS CAP IN MONUMENT BOX  
S30E 21.20' TOP CTR OF 12" CMP  
EAST 41.17' 1/2" REROD IN PAVEMENT  
EAST 47.55' 1/2" REROD W/CAP IN PAVEMENT  
N15E 34.81' TOP CTR OF MBT RISER

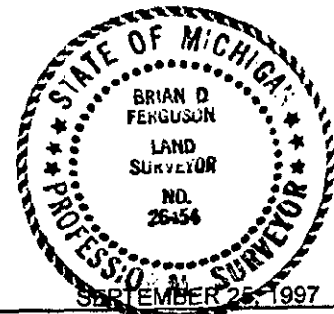

Signed by *Brian D. Ferguson*  
Surveyor's Michigan License No. 26454

Date SEPTEMBER 25, 1997