

LAND CORNER RECORDATION CERTIFICATE
 Filing Requirement of Act 74, Mich. P.A. 1970

RECORDED/FILED

For corners in **SAGINAW COUNTY REMONUMENTATION**

1997 SEP 26 P 3: 29

MILDRED M. DODAK
 REGISTER OF DEEDS
 SAGINAW COUNTY, MI.

LIBER 2027 PAGE 461

Liber 7 Page 152

Register of Deeds Stamp & File Number

- Located in: B'RUN TWP. Corner Code #
- SAGINAW (County)
1. Public Land Survey T 10N R 6E I-13
 T _____ R _____
2. Property Controlling in Section S _____ T _____ R _____
 S _____ T _____ R _____
3. Miscellaneous Property in Sec. S _____ T _____ R _____
 S _____ T _____ R _____
4. Lot No. _____, Recorded Plat _____
5. Private Claims _____

I, BRIAN D FERGUSON, in a field survey on JUNE 17, 19 97 do hereby state that under requirements of P.A. 74, Michigan P.A. of 1970, the corner points mentioned in lines 1 and 2 above were in conformance with regulations and rules therefore as required in the current manual of survey instructions of the United States Department of the Interior, Bureau of Land Management or by a decree of a Court of Law and/or that the corner points mentioned in lines 3, 4 and 5 above were in conformance with the rules of the Michigan Board of Land Surveyors or by a Decree of a Court of Law; established, re-established, monumented, recovered, found as expressed below:

NOTE: Not more than 2 corners, all in the same town and range, may be recorded on this certificate.

	A	B	C	D	E	F	G	H	I	J	K	L	M
1													
2	6		5		4		3		2		1		
3													
4	7		8		9		10		11		12		
5													
6	18		17		16		15		14		13		
7													
8	19		20		21		22		23		24		
9													
10	30		29		28		27		26		25		
11													
12	31		32		33		34		35		36		
13													

A. Description of original monument and accessories and/or subsequent restoration:

I-13: WOOD POST SET BY WAMPLER IN 1822
 SURVEY &
 REMONUMENTATION

MAR 18 1998

APPROVED BY PEER GROUP
 P.A. 345 OF 1990
 SAGINAW COUNTY

9-18-97 BDF


SECTION

B. Description of corner evidence found and/or method applied in restoring or reestablishing corner:

I-13: FOUND 3/4" IRON PIPE
 LCRC RECORDED IN L 5 PG 267
 RECORDED SURVEYS L 1513 PG 93, L1513 PG 92
 TWO PLATS, L 6 PG 10 AND L 6 PAGE 13
 ACCEPTED BY THE PEER REVIEW GROUP AS THE BEST
 AVAILABLE EVIDENCE OF THE POSITION OF THE ORIGINAL CORNER

C. Description of monument for corner and accessories established to perpetuate locating the position of the corner:

I-13: SET 5/8" ROD W/3" BRASS CAP IN MONUMENT BOX
 N30E 43.15' NAIL SE FCE 48" OAK TREE
 EAST 47.64' 1/2" REROD IN ROAD (J-1, T9N-R6E)
 N45W 47.65' PK NAIL IN S FCE 14" MAPLE TREE
 SOUTH 8.04' EDGE OF PAVEMENT.

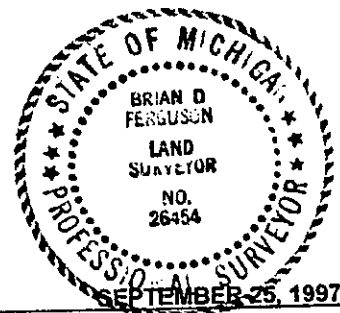

Signed by *Brian D Ferguson*
 Surveyor's Michigan License No. 26454

Date SEPTEMBER 25, 1997