

LAND CORNER RECORDATION CERTIFICATE
 Filing Requirement of Act 74, Mich. P.A. 1970

RECORDED/FILED

For corners in **SAGINAW COUNTY REMONUMENTATION**

1997 SEP 26 P 3: 29

SAGINAW Located in: B'RUN TWP. Corner Code #
 (County)

MILDRED M. DODAK
 REGISTER OF DEEDS
 SAGINAW COUNTY, MI.

- | | | |
|------------------------------------|--------------------------|-------------|
| 1. Public Land Survey | T <u>10N</u> R <u>6E</u> | <u>K-13</u> |
| | T _____ R _____ | _____ |
| 2. Property Controlling in Section | S _____ T _____ R _____ | _____ |
| | S _____ T _____ R _____ | _____ |
| 3. Miscellaneous Property in Sec. | S _____ T _____ R _____ | _____ |
| | S _____ T _____ R _____ | _____ |

LIBER 2027 PAGE 463

Lib 7 Page 154

Register of Deeds Stamp & File Number

4. Lot No. _____, Recorded Plat _____
5. Private Claims _____

1	A	B	C	D	E	F	G	H	I	J	K	L	M
2		6		5		4		3		2		1	
3													
4		7		8		9		10		11		12	
5													
6		18		17		16		15		14		13	
7													
8		19		20		21		22		23		24	
9													
10		30		29		28		27		26		25	
11													
12		31		32		33		34		35		36	
13													

I, BRIAN D FERGUSON, in a field survey on JUNE 17, 19 97 do hereby state that under requirements of P.A. 74, Michigan P.A. of 1970, the corner points mentioned in lines 1 and 2 above were in conformance with regulations and rules therefore as required in the current manual of survey instructions of the United States Department of the Interior, Bureau of Land Management or by a decree of a Court of Law and/or that the corner points mentioned in lines 3, 4 and 5 above were in conformance with the rules of the Michigan Board of Land Surveyors or by a Decree of a Court of Law; established, re-established, monumented, recovered, found as expressed below:

NOTE: Not more than 2 corners, all in the same town and range, may be recorded on this certificate.

A. Description of original monument and accessories and/or subsequent restoration:

K-13: WOOD POST SET BY WAMPLER IN 1822

APPROVED BY PEER GROUP
 P.A. 345 OF 1990
 SAGINAW COUNTY
9-18-97 *[Signature]*

B. Description of corner evidence found and/or method applied in restoring or reestablishing corner:

K-13: FOUND 3/4" IRON PIPE
AGREES WITH LOCATION BASED ON FIELD NOTES AND SECTION COMPUTATIONS BY RC ASSOCIATES AND LEACH ENGINEERING CO.


ACCEPTED BY THE PEER REVIEW GROUP AS THE BEST AVAILABLE EVIDENCE OF THE POSITION OF THE ORIGINAL CORNER

C. Description of monument for corner and accessories established to perpetuate locating the position of the corner:

K-13: SET 5/8" ROD W/3" BRASS CAP IN MONUMENT BOX
S30W 25.73' NAIL & TAG IN NE FCE PWR POLE
EAST 65.60' 1" IRON BAR IN RD (K-1, T9N-R6E)
N25W 45.25' FCE STREET SIGN POST
S45E 57.00' FCE STOP SIGN POST

SURVEY &
 REMONUMENTATION

MAR 18 1998

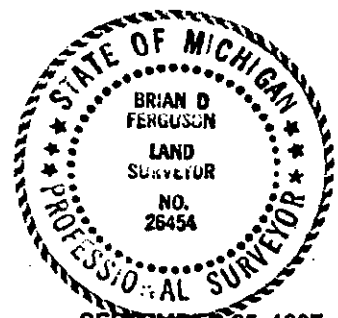

Signed by *Brian D. Ferguson* SECTION _____
 Surveyor's Michigan License No. 26454

Date _____ SEPTEMBER 25, 1997