

LAND CORNER RECORDATION CERTIFICATE
Filing Requirement of Act 74, Mich. P.A. 1970

RECORDED/FILED

For corners in

SAGINAW COUNTY REMONUMENTATION

1997 SEP 26 P 3:29

MILDRED M. DODAK
REGISTER OF DEEDS
SAGINAW COUNTY, MI.

LIBER 2027 PAGE 464

Liber 7 Page 155

Register of Deeds Stamp & File Number

Located in: B'RUN TWP. Corner Code # _____

<u>SAGINAW</u> (County)	<u>T 10N R 6E</u>	<u>L-13</u>
1. Public Land Survey	T _____ R _____	_____
2. Property Controlling in Section	S _____ T _____ R _____	_____
3. Miscellaneous Property in Sec.	S _____ T _____ R _____	_____

4. Lot No. _____, Recorded Plat _____

5. Private Claims _____

1	A	B	C	D	E	F	G	H	I	J	K	L	M
2	6		5		4		3		2		1		
3													
4	7		8		9		10		11		12		
5													
6	18		17		16		15		14		13		
7													
8	19		20		21		22		23		24		
9													
10	30		29		28		27		26		25		
11													
12	31		32		33		34		35		36		
13													

I, BRIAN D FERGUSON in a field survey on JUNE 17, 19 97 do hereby state that under requirements of P.A. 74, Michigan P.A. of 1970, the corner points mentioned in lines 1 and 2 above were in conformance with regulations and rules therefore as required in the current manual of survey instructions of the United States Department of the Interior, Bureau of Land Management or by a decree of a Court of Law and/or that the corner points mentioned in lines 3, 4 and 5 above were in conformance with the rules of the Michigan Board of Land Surveyors or by a Decree of a Court of Law; established, re-established, monumented, recovered, found as expressed below:

NOTE: Not more than 2 corners, all in the same town and range, may be recorded on this certificate.

A. Description of original monument and accessories and/or subsequent restoration:

L-13: WOOD POST SET BY WAMPLER IN 1822

APPROVED BY PEER GROUP
P.A. 345 OF 1990
SAGINAW COUNTY

9-18-97 *[Signature]*

B. Description of corner evidence found and/or method applied in restoring or reestablishing corner:

L-13: FOUND 3/4" IRON PIPE
AGREES WITH LOCATION BASED ON FIELD NOTES AND SECTION COMPUTATIONS BY RC ASSOCIATES AND LEACH ENGINEERING CO.

ACCEPTED BY THE PEER REVIEW GROUP AS THE BEST AVAILABLE EVIDENCE OF THE POSITION OF THE ORIGINAL CORNER


C. Description of monument for corner and accessories established to perpetuate locating the position of the corner:

L-13: SET 5/8" ROD W/3" BRASS CAP IN MONUMENT BOX
S45W 46.73' NE FCE 30" OAK
N10W 30.01' TOP CTR MBT RISER
N30E 37.80' SW FCE 40" OAK
NORTH 19.45' S FCE 12" CONIFER TREE

SURVEY &
REMONUMENTATION

MAR 18 1998

SECTION

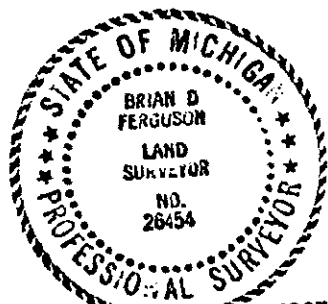

Signed by *Brian D Ferguson*
Surveyor's Michigan License No. 26454

Date SEPTEMBER 25, 1997