

LAND CORNER RECORDATION CERTIFICATE  
 Filing Requirement of Act 74, Mich. P.A. 1970

RECORDED/FILED

For corners in

SAGINAW COUNTY REMONUMENTATION

SAGINAW  
 (County)

Located in: B'RUN TWP. Corner Code #

1997 SEP 26 P 3: 26

MILDRED M. DODAK  
 REGISTER OF DEEDS  
 SAGINAW COUNTY, MI.

LIBER 2027 PAGE 456

*Liber 7 Page 147*

Register of Deeds Stamp & File Number

1. Public Land Survey
2. Property Controlling in Section
3. Miscellaneous Property in Sec.

	T	10N	R	6E	M-4
S	T		R		
S	T		R		
S	T		R		
S	T		R		

4. Lot No. \_\_\_\_\_ Recorded Plat \_\_\_\_\_
5. Private Claims \_\_\_\_\_

I, BRIAN D FERGUSON, in a field survey on JUNE 17, 19 97 do hereby state that under requirements of P.A. 74, Michigan P.A. of 1970, the corner points mentioned in lines 1 and 2 above were in conformance with regulations and rules therefore as required in the current manual of survey instructions of the United States Department of the Interior, Bureau of Land Management or by a decree of a Court of Law and/or that the corner points mentioned in lines 3, 4 and 5 above were in conformance with the rules of the Michigan Board of Land Surveyors or by a Decree of a Court of Law; established, re-established, monumented, recovered, found as expressed below:

NOTE: Not more than 2 corners, all in the same town and range, may be recorded on this certificate.

1	A	B	C	D	E	F	G	H	I	J	K	L
2	6		5		4		3		2			
3												
4	7		8		9		10		11			12
5												
6	16		17		18		19		20			21
7												
8	18		20		21		22		23			24
9												
10	30		29		28		27		26			25
11												
12	31		32		33		34		35			36
13												


- A. Description of original monument and accessories and/or subsequent restoration:  
**M-4: WOOD POST SET BY WAMPLER IN 1822**

APPROVED BY PEER GROUP  
 P.A. 345 OF 1990  
 SAGINAW COUNTY  
*9-18-97 BDF*

- B. Description of corner evidence found and/or method applied in restoring or reestablishing corner:  
**M-4: FOUND "T"**  
 LCRC RECORDED IN L 1 PG 174  
 SURVEY RECORDED IN L 1362 PG 233  
 ACCEPTED BY THE PEER REVIEW GROUP AS THE BEST  
 AVAILABLE EVIDENCE OF THE POSITION OF THE ORIGINAL CORNER

- C. Description of monument for corner and accessories established to perpetuate locating the position of the corner:  
**M-4: SET 5/8" ROD W/3" BRASS CAP IN MONUMENT BOX**  
 S15E 41.43' NAIL IN N. FCE 10" OAK TREE  
 S45E 24.62' NAIL IN W. FCE 18" OAK TREE  
 N75W 42.41' TOP CTR OF 48" CONC. PIPE  
 S75W 64.10' TOP CTR OF 48" CONC. PIPE

Signed by *Brian D Ferguson*  
 Surveyor's Michigan License No. 26454  
 REMONUMENTATION

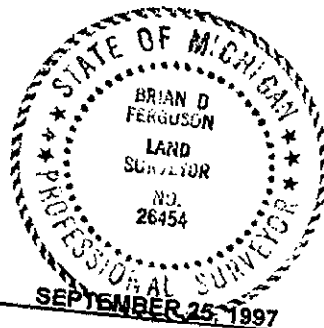

Date SEPTEMBER 25, 1997

MAR 18 1998

SECTION