

**LAND CORNER RECORDATION CERTIFICATE**  
 Filing Requirement of Act 74, Mich. P.A. 1970

RECORDED/FILED

For corners in **SAGINAW COUNTY REMONUMENTATION**

1997 SEP 26 P 3: 26

SAGINAW Located in: B'RUN TWP. Corner Code #  
 (County)

MILDRED M. OODAK  
 REGISTER OF DEEDS  
 SAGINAW COUNTY, MI.

- |                                    |                          |            |
|------------------------------------|--------------------------|------------|
| 1. Public Land Survey              | T <u>10N</u> R <u>6E</u> | <u>M-7</u> |
|                                    | T _____ R _____          | _____      |
| 2. Property Controlling in Section | S _____ T _____ R _____  | _____      |
|                                    | S _____ T _____ R _____  | _____      |
| 3. Miscellaneous Property in Sec.  | S _____ T _____ R _____  | _____      |
|                                    | S _____ T _____ R _____  | _____      |

LIBER 2027 PAGE 453

*Lib 7 Page 144*

Register of Deeds Stamp & File Number

4. Lot No. \_\_\_\_\_ Recorded Plat \_\_\_\_\_  
 5. Private Claims \_\_\_\_\_

	A	B	C	D	E	F	G	H	I	J	K	L	M
1													
2	6			5		4		3		2			
3													
4	7			8		9		10		11		12	
5													
6	16			17		18		15		14		13	
7													
8	19			20		21		22		23		24	
9													
10	30			29		28		27		26		25	
11													
12	31			32		33		34		35		36	
13													

I, BRIAN D FERGUSON, in a field survey on JUNE 17, 19 97 do hereby state that under requirements of P.A. 74, Michigan P.A. of 1970, the corner points mentioned in lines 1 and 2 above were in conformance with regulations and rules therefore as required in the current manual of survey instructions of the United States Department of the Interior, Bureau of Land Management or by a decree of a Court of Law and/or that the corner points mentioned in lines 3, 4 and 5 above were in conformance with the rules of the Michigan Board of Land Surveyors or by a Decree of a Court of Law; established, re-established, monumented, recovered, found as expressed below:

NOTE: Not more than 2 corners, all in the same town and range, may be recorded on this certificate.

A. Description of original monument and accessories and/or subsequent restoration:

**M-7: WOOD POST SET BY WAMPLER IN 1822**

APPROVED BY PEER GROUP  
 P.A. 345 OF 1990  
 SAGINAW COUNTY  
9-18-97 *BD*


B. Description of corner evidence found and/or method applied in restoring or reestablishing corner:

**M-7: FOUND 3/4" IRON ROD  
 SURVEY RECORDED IN L 1777 PG 1337, L 1373 PG 698  
 LCRC RECORDED IN L 2 PG 69**

**ACCEPTED BY THE PEER REVIEW GROUP AS THE BEST  
 AVAILABLE EVIDENCE OF THE POSITION OF THE ORIGINAL CORNER**

C. Description of monument for corner and accessories established to perpetuate locating the position of the corner:

**M-7: SET 5/8" ROD W/3" BRASS CAP IN MONUMENT BOX  
 N20W 40.87' FCE GAS LINE MARKER  
 N30E 60.89' TOP CTR OF BELL TELEPHONE RISER  
 EAST 36.25' NORTH LEG OF SIGN POST  
 S70W 37.53' CTR OF STOP SIGN POST**

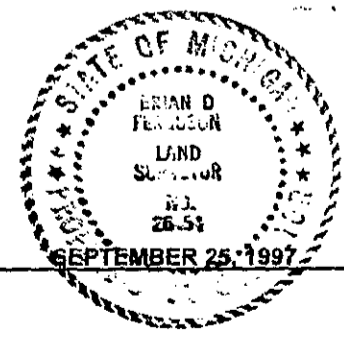

Signed by *Brian D Ferguson*  
 Surveyor's Michigan License No. 26454

Date \_\_\_\_\_

SURVEY &  
 REMONUMENTATION

MAR 18 1998