

LAND CORNER RECORDATION CERTIFICATE
 Filing Requirement of Act 74, Mich. P.A. 1970

RECORDED/FILED

For corners in

SAGINAW COUNTY REMONUMENTATION

1997 SEP 26 P 3: 26

MILDRED M. DODAK
 REGISTER OF DEEDS
 SAGINAW COUNTY, MI.

EIBER 2027 PAGE 452

Liber 7 Page 143

Register of Deeds Stamp & File Number

<u>SAGINAW</u> (County)	Located in: <u>B'RUN TWP.</u>	Corner Code #
1. Public Land Survey	<u>T 10N R 6E</u>	<u>M-8</u>
	<u>T</u> <u>R</u>	<u></u>
2. Property Controlling in Section	<u>S</u> <u>T</u> <u>R</u>	<u></u>
	<u>S</u> <u>T</u> <u>R</u>	<u></u>
3. Miscellaneous Property in Sec.	<u>S</u> <u>T</u> <u>R</u>	<u></u>
	<u>S</u> <u>T</u> <u>R</u>	<u></u>
4. Lot No. _____	Recorded Plat _____	
5. Private Claims _____	_____	

I, BRIAN D FERGUSON, in a field survey on JUNE 17, 19 97 do hereby state that under requirements of P.A. 74, Michigan P.A. of 1970, the corner points mentioned in lines 1 and 2 above were in conformance with regulations and rules therefore as required in the current manual of survey instructions of the United States Department of the Interior, Bureau of Land Management or by a decree of a Court of Law and/or that the corner points mentioned in lines 3, 4 and 5 above were in conformance with the rules of the Michigan Board of Land Surveyors or by a Decree of a Court of Law; established, re-established, monumented, recovered, found as expressed below:

NOTE: Not more than 2 corners, all in the same town and range, may be recorded on this certificate.

1	A	B	C	D	E	F	G	H	I	J	K	L	M
2		6		5		4		3		2		1	
3													
4		7		8		9		10		11		12	
5													
6		18		17		16		15		14		13	
7													
8		19		20		21		22		23		24	
9													
10		30		29		28		27		26		25	
11													
12		31		32		33		34		35		36	
13													

A. Description of original monument and accessories and/or subsequent restoration:

M-8: WOOD POST SET BY WAMPLER IN 1822

APPROVED BY PEER GROUP
 P.A. 345 OF 1990
 SAGINAW COUNTY
9-18-97 *[Signature]*


B. Description of corner evidence found and/or method applied in restoring or reestablishing corner:

M-8: FOUND 3/4" IRON ROD
 SURVEY RECORDED IN L 1777 PG 1337
 LCRC RECORDED IN L 3 PG 221

ACCEPTED BY THE PEER REVIEW GROUP AS THE BEST
 AVAILABLE EVIDENCE OF THE POSITION OF THE ORIGINAL CORNER

C. Description of monument for corner and accessories established to perpetuate locating the position of the corner:

M-8: SET 5/8" ROD W/3" BRASS CAP IN MONUMENT BOX
 N20E 91.10' NAIL IN SW FCE 24" CONIFER TREE
 S70E 79.88' W. FCE OF 10" APPLE TREE
 S60W 41.87' CLUMP OF 8" BIRCH TREES
 N45W 29.23' FCE STREET SIGN POST

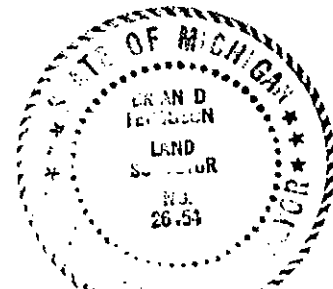

Signed by *Brian D Ferguson*
 Surveyor's Michigan License No. 26454

Date SEPTEMBER 25, 1997

**SURVEY &
 REMONUMENTATION**

FORM APPROVED BY MICHIGAN STATE BOARD OF PROFESSIONAL SURVEYORS, JAN. 28, 1971
 REVISED MAY 14, 1975
 REVISED JAN., 1983
 REVISED OCT., 1995

MAR 18 1998

SECTION