LAND CORNER RECORDATION CERTIFICATE

Filing Requirement of Act 74, Mich. P.A. 1970

RECORDED/FILED

1997 SEP 26 P 3:26

MILDRED M. DODAK
REGISTER OF DEEDS
SAGINAW COUNTY, MI.

LIBER 2027 PAGE 451

Liber 7 Page 142

Register of Deeds Stamp & File Number

For corners in **SAGINAW COUNTY REMONUMENTATION**

SAGINAW (County) Located in: B'RUN TWP. Corner Code #

1. Public Land Survey T 10N R 6E M-9
   T____ R____
2. Property Controlling S____ T____ R____
   in Section S____ T____ R____
3. Miscellaneous S____ T____ R____
   Property in Sec. S____ T____ R____

4. Lot No._____, Recorded Plat_____
5. Private Claims_____

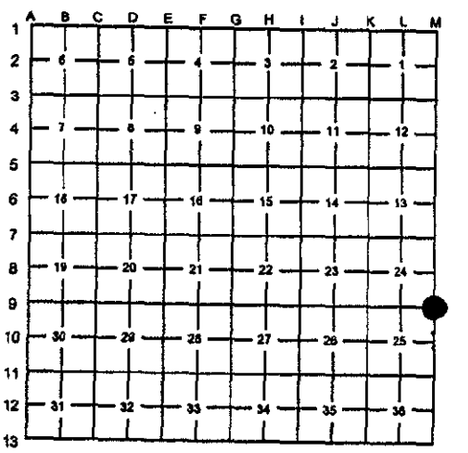

I, BRIAN D FERGUSON, in a field survey on JUNE 17, 19 97 do hereby state that under requirements of P.A. 74, Michigan P.A. of 1970, the corner points mentioned in lines 1 and 2 above were in conformance with regulations and rules therefore as required in the current manual of survey instructions of the United States Department of the Interior, Bureau of Land Management or by a decree of a Court of Law and/or that the corner points mentioned in lines 3, 4 and 5 above were in conformance with the rules of the Michigan Board of Land Surveyors or by a Decree of a Court of Law; established, re-established, monumented, recovered, found as expressed below:

NOTE: Not more than 2 corners, all in the same town and range, may be recorded on this certificate.

A. Description of original monument and accessories and/or subsequent restoration:

M-9: WOOD POST SET BY WAMPLER IN 1822

APPROVED BY PEER GROUP
P.A. 345 OF 1990
SAGINAW COUNTY
9-18-97

B. Description of corner evidence found and/or method applied in restoring or reestablishing corner:

M-9: FOUND 3/4" IRON ROD
SURVEY RECORDED IN L 1394 PG 432
LCRC RECORDED IN L 1 PG 153

ACCEPTED BY THE PEER REVIEW GROUP AS THE BEST AVAILABLE EVIDENCE OF THE POSITION OF THE ORIGINAL CORNER

C. Description of monument for corner and accessories established to perpetuate locating the position of the corner:

M-9: SET 5/8" ROD W/3" BRASS CAP IN MONUMENT BOX
S45W 59.70' 1" PIPE
S45E 69.70' PK NAIL IN PWR POLE
N35W 74.40' CTR OF STREET SIGN POST
EAST 11.10 N. LEG SIGN POST

STATE OF MICHIGAN
BRIAN D FERGUSON
LAND SURVEYOR
NO. 26454

Signed by B. D. Ferguson

Date SEPTEMBER 25, 1997

Surveyor's Michigan License No. 26454

SURVEY & REMONUMENTATION

MAR 18 1998

SECTION

FORM APPROVED BY MICHIGAN STATE BOARD OF PROFESSIONAL SURVEYORS, JAN. 28, 1971
REVISED MAY 14, 1975
REVISED JAN., 1983
REVISED OCT., 1995