

**SURVEY &
REMONUMENTATION**

APPROVED BY PEER GROUP APR 24 1995 LIBER 1925 PAGE 1152

Lib 6 Page 277

**SAGINAW COUNTY REMONUMENTATION
LAND CORNER RECORDATION CERTIFICATE**
Filing Requirement of Act 74, Mich. P.A. 1970

For corners in

<u>Saginaw</u> <small>(County)</small>	Located In:	Corner Code #
1. Public Land Survey	T <u>11N</u> R <u>4E</u>	<u>D-1</u>
	T _____ R _____	_____
	T _____ R _____	_____
	T _____ R _____	_____
2. Property Controlling in Section	S _____ T _____ R _____	_____
	S _____ T _____ R _____	_____
3. Miscellaneous Property in Sec.	S _____ T _____ R _____	_____
	S _____ T _____ R _____	_____
4. Lot No. _____, Recorded Plat _____		
5. Private Claims _____		

REGISTER OF DEEDS
 SAGINAW COUNTY MICH.
 Dec 29 9 29 AM '94

RECORDED & FILED

Register of Deeds Stamp & File Number

I, Duane F. Ledy, in a field survey on September, 19 94, do hereby certify that under requirements of P.A. 74, Michigan P.A. of 1970, the corner points mentioned in lines 1 and 2 above were in conformance with regulations and rules therefore as required in the current manual of survey instructions of the United States Department of the Interior, Bureau of Land Management or by a decree of a Court of Law and/or that the corner points mentioned in lines 3, 4 and 5 above were in conformance with the rules of the Michigan Board of Land Surveyors or by a Decree of a Court of Law; established, re-established, monumented, re-monumented, recovered, found as expressed below:

A	B	C	D	E	F	G	H	I	J	K	L	M
2	6	5	4	3	2	1						
3												
4	7	8	9	10	11	12						
5												
6	18	17	16	15	14	13						
7												
8	19	20	21	22	23	24						
9												
10	30	29	28	27	26	25						
11												
12	31	32	33	34	35	36						
13												

NOTE: Not more than 4 corners, all in the same town and range, may be recorded on this certificate.

A. Description of original monument and accessories and/or subsequent restoration:

D-1 No corner set by G.L.O.
 Prorated closure at Township line, 4.25 links (2.80').
 Spicer Eng. notes (no date) at D-1 & D-13 show a 3/4" pipe found at position used by Cooper & Ender (unrecorded) in 1958 as D-1.
 Spicer Eng. survey (L1355, P1047) used same corner, 1972.
 No records of previous restoration or subsequent surveys at this corner.


B. Description of corner evidence found and/or method applied in restoring or reestablishing corner:

D-1 Found 3/4" pipe.
 Witnesses in Spicer Eng. notes not recorded.
 No other witnesses available to perpetuate corner position.

 Position of existing 3/4" pipe accepted as best possible position of original corner.
 Position accepted by Saginaw County Peer Review Group on December 7, 1994.

C. Description of monument for corner and accessories established to perpetuate locating the position of the corner:

D-1 Set 3" Saginaw County brass cap on 5/8" x 18" rebar over existing 3/4" pipe.
 East 11.25' to Saginaw County Remonumentation brass cap (D-13).
 S 40° W 65.20' to nail and tag in west face of 26" Willow.
 S 10° E 72.50' to nail and tag in west face of 30" Cottonwood.
 N 80° W 38.33' to nail and tag in south face of 6" Ash.
 N 40° E 15.15' to 3/4" pipe.

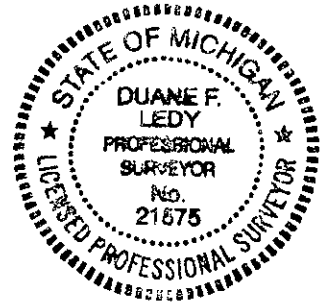

Signed by Duane F. Ledy Date December 27, 1994
 Surveyor's Michigan License No. 21575