

APPROVED BY PEER GROUP  
P.A. 345 OF 1990  
SAGINAW COUNTY

1997 REMONUMENTATION PROGRAM  
LAND CORNER RECORDATION CERTIFICATE  
Filing Requirement of Act 74, Mich. P.A. 1970

RECORDED/FILED  
LIBER 2028 PAGE 442  
1997 OCT -3 A 8:28

For corners in: FRANKENMUTH TWP.

MILDRED M. DODAK  
REGISTER OF DEEDS  
SAGINAW COUNTY, MI.

<u>SAGINAW</u> (County)	Located In:	Corner Code #
1. Public Land Survey	T <u>11N</u> R <u>06E</u>	<u>M-3</u>
	T _____ R _____	_____
	T _____ R _____	_____
2. Property Controlling in Section	S _____ T _____ R _____	_____
	S _____ T _____ R _____	_____
3. Miscellaneous Property in Sec.	S _____ T _____ R _____	_____
	S _____ T _____ R _____	_____

*Liber 7 Page 187*  
Register of Deeds Stamp & File Number

4. Lot No. \_\_\_\_\_ Recorded Plat \_\_\_\_\_  
5. Private Claims \_\_\_\_\_

	A	B	C	D	E	F	G	H	I	J	K	L
1												
2	6	5	4	3	2	1						
3												
4	7	8	9	10	11	12						
5												
6	18	17	16	15	14	13						
7												
8	19	20	21	22	23	24						
9												
10	30	29	28	27	26	25						
11												
12	31	32	33	34	35	36						
13												

I, JONATHAN M. FIELD, in a field survey on JULY 8 19 97, do hereby certify that under requirements of P.A. 74, Michigan P.A. of 1970, the corner points mentioned in lines 1 and 2 above were in conformance with regulations and rules therefore as required in the current manual of survey instructions of the United States Department of the Interior, Bureau of Land Management or by a decree of a Court of Law and/or that the corner points mentioned in lines 3, 4 and 5 above were in conformance with the rules of the Michigan Board of Land Surveyors or by a Decree of a Court of Law; established, re-established, monumented, re-monumented, recovered, found as expressed below:


NOTE: Not more than 4 corners, all in the same town and range, may be recorded on this certificate.

A. Description of original monument and accessories and/or subsequent restoration:  
1821 GLO; WAMPLER, D.S.; SET POST; ELM 5 N32E 4 1/2LKS., ASH 14 N48W 4LKS.  
1977 MARTIN, LS#4699 LCRC L.4, PG.57; FND. T-IRON; N45W 44.25' P.POLE, S45E 42.30' T.POLE, S45W 30.00' NW COR HEADWALL

B. Description of corner evidence found and/or method applied in restoring or reestablishing corner:  
1997 ROWE; FIELD, PS#37276; FND. NO EVIDENCE OF MONUMENT AT CORNER; RE-ESTABLISHED CORNER POSITION USING 2 REMAINING WITNESSES FROM 1977 MARTIN LCRC CITED IN SECTION A. ABOVE

ACCEPTED AS A CAREFUL AND FAITHFUL RE-ESTABLISHMENT OF THE ORIGINAL CORNER POSITION

C. Description of monument for corner and accessories established to perpetuate locating the position of the corner:  
M-3 SET 5/8" ROD W/ STD. REMON. CAP IN MON. BOX  
NORTH, 257.30' FND. R.R. SPIKE  
S45°W, 30.00' NW CORNER CONC. HEADWALL  
N45°W, 44.70' NAIL W/TAG IN SW FACE P.POLE  
S45°E, 42.48' P-K NAIL W/TAG #37276 IN NE FACE CUT-OFF T.POLE  
N65°E, 28.93' CHIS. NOTCH IN NE END 48" CMP

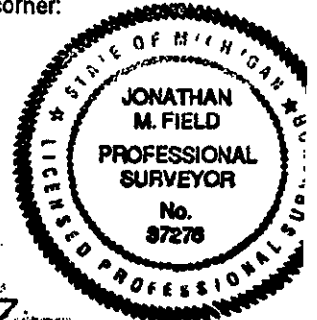

Signed by Jonathan M. Field  
Surveyor's Michigan License No. 37276

Date 9-25-97

FORM APPROVED BY MICHIGAN STATE BOARD OF LAND SURVEYORS, JAN. 21

SURVEY &  
REMONUMENTATION

REVISED MAY 6  
REVISED JAN  
ADAPTED FOR WORD PROCESSING MAR 03

MAR 18 1998

SECTION