

APPROVED BY PEER GROUP  
P.A. 345 OF 1990  
SAGINAW COUNTY

1997 REMONUMENTATION PROGRAM  
LAND CORNER RECORDATION CERTIFICATE  
Filing Requirement of Act 74, Mich. P.A. 1970

RECORDED/FILED

1997 OCT -3 A 8: 28

MILDRED M. DODAK  
REGISTER OF DEEDS  
SAGINAW COUNTY, MI.

LIBER 2028 PAGE 431

*Liber 7 Page 176*  
Register of Deeds Stamp & File Number

8-28-97  
For corners in: FRANKENMUTH TWP.

<u>SAGINAW</u> (County)	Located In:	Corner Code #
1. Public Land Survey	T <u>11N</u> R <u>06E</u>	<u>M-4</u>
	T _____ R _____	_____
	T _____ R _____	_____
	T _____ R _____	_____
2. Property Controlling in Section	S _____ T _____ R _____	_____
	S _____ T _____ R _____	_____
3. Miscellaneous Property in Sec.	S _____ T _____ R _____	_____
	S _____ T _____ R _____	_____

4. Lot No. \_\_\_\_\_, Recorded Plat \_\_\_\_\_  
5. Private Claims \_\_\_\_\_

I, JONATHAN M. FIELD, in a field survey on JULY 8 19 97, do hereby certify that under requirements of P.A. 74, Michigan P.A. of 1970, the corner points mentioned in lines 1 and 2 above were in conformance with regulations and rules therefore as required in the current manual of survey instructions of the United States Department of the Interior, Bureau of Land Management or by a decree of a Court of Law and/or that the corner points mentioned in lines 3, 4 and 5 above were in conformance with the rules of the Michigan Board of Land Surveyors or by a Decree of a Court of Law; established, re-established, monumented, re-monumented, recovered, found as expressed below:

NOTE: Not more than 4 corners, all in the same town and range, may be recorded on this certificate.


	A	B	C	D	E	F	G	H	I	J	K	L
1												
2	6	5	4	3	2							
3												
4	7	8	9	10	11							
5												
6	18	17	16	15	14							
7												
8	19	20	21	22	23							
9												
10	30	29	28	27	26							
11												
12	31	32	33	34	35							
13												

A. Description of original monument and accessories and/or subsequent restoration:  
1821 GLO; WAMPLER, D.S.; SET 1/4 SEC. POST; BEECH 18 S10E 7LKS., BEECH 11 N32W 21LKS.  
1959 BLACK, LS#3384; WIT CARD FOR A-4 T11N-R7E SHOWS M-4 T11N-R6E 250.6' S.  
1972 CPCO; DORCEY, LS#9429; M-4 T11N-R6E SHOWN 248.37' S. OF A-4 T11N-R7E; NO OBJECTS STATED; NO WITS GIVEN  
1973 LEACH, LS#7236; LCRC L.2, PG.141; FND. T-IRON; W 24.93' P.POLE, NE 37.00' N. FENCE POST

B. Description of corner evidence found and/or method applied in restoring or reestablishing corner:  
1997 ROWE; FIELD, PS#37276; FND. T-IRON 1.4' W. OF C/L REESE ROAD & ON TREE LINE TO W.; RECOVERED 1 PREVIOUS WITNESS WHICH INDICATES THAT FND. T-IRON IS IN SAME POSITION AS 1972 CPCO SURVEY CITY IN SECTION A. ABOVE; DID NOT HOLD T-IRON; ALSO FND. 1" ROD W/ LARGE STONES BELOW 10.16' E. OF T-IRON

ACCEPTED FND. T-IRON AS A CAREFUL AND FAITHFUL PERPETUATION OF THE ORIGINAL CORNER POSITION

C. Description of monument for corner and accessories established to perpetuate locating the position of the corner:  
M-4 REPLACED FND. ROD W/ 5/8" ROD & STD. REMON CAP IN MON. BOX  
N02°W, 251.01' FND. T-IRON  
S50°W, 11.82' FND. R.R. SPIKE  
S88°W, 34.88' NAIL W/TAG IN S. FACE P.POLE  
S02°E, 38.41' 1/2" ROD W/CAP #37276  
N35°W, 43.64' 1/2" ROD W/CAP #37276  
N02°E, 39.82' 1/2" ROD W/CAP #37276

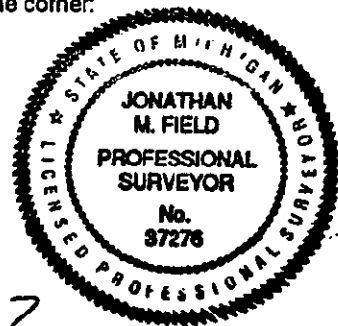

Signed by Jonathan M. Field Date 9-25-97  
Surveyor's Michigan License No. 37276  
REMONUMENTATION

FORM APPROVED BY MICHIGAN STATE BOARD OF LAND SURVEYORS, JAN. 21

REVISED MAY 81  
REVISED JAN 82  
ADAPTED FOR WORD PROCESSING MARCH 83

MAR 18 1998

SECTION