

APPROVED BY PEER GROUP
P.A. 345 OF 1990
SAGINAW COUNTY

1997 REMONUMENTATION PROGRAM
LAND CORNER RECORDATION CERTIFICATE
Filing Requirement of Act 74, Mich. P.A. 1970

RECORDED/FILED
LIBER 2028 PAGE 440
1997 OCT -3 A 8: 28

MILDRED H. DODAK
REGISTER OF DEEDS
SAGINAW COUNTY, MI.

For corners in: FRANKENMUTH TWP.

SAGINAW Located In: _____ Corner Code # _____
(County)

1. Public Land Survey T 11N R 06E _____ M-6
T _____ R _____
T _____ R _____
T _____ R _____

2. Property Controlling S _____ T _____ R _____
in Section S _____ T _____ R _____

3. Miscellaneous S _____ T _____ R _____
Property in Sec. S _____ T _____ R _____

4. Lot No. _____ Recorded Plat _____

5. Private Claims _____

Liber 7 Page 185

Register of Deeds Stamp & File Number

	A	B	C	D	E	F	G	H	I	J	K	L	M
1													
2	6	5	4	3	2	1							
3													
4	7	8	9	10	11	12							
5													
6	18	17	16	15	14	13							
7													
8	19	20	21	22	23	24							
9													
10	30	29	28	27	26	25							
11													
12	31	32	33	34	35	36							
13													

I, JONATHAN M. FIELD, in a field survey on JULY 8 19 97, do hereby certify that under requirements of P.A. 74, Michigan P.A. of 1970, the corner points mentioned in lines 1 and 2 above were in conformance with regulations and rules therefore as required in the current manual of survey instructions of the United States Department of the Interior, Bureau of Land Management or by a decree of a Court of Law and/or that the corner points mentioned in lines 3, 4 and 5 above were in conformance with the rules of the Michigan Board of Land Surveyors or by a Decree of a Court of Law; established, re-established, monumented, re-monumented, recovered, found as expressed below:


NOTE: Not more than 4 corners, all in the same town and range, may be recorded on this certificate.

A. Description of original monument and accessories and/or subsequent restoration:
1821 GLO; WAMPLER, D.S.; NOT SET; "BALANCE OF THIS MILE & SEC. 24 & 13 & PART OF 12 IN RESERVATION"
1839 GLO; MULLETT, D.S.; SET 1/4 SEC. POST; BASH 8 S8W 2.5LKS., LYNN 8 N20W 15LKS.
1968 CPCO; BOLDT; WITS FOR A-6 T11N-R7E SHOW SOUTH 204.15' TO M-6

B. Description of corner evidence found and/or method applied in restoring or reestablishing corner:
1997 ROWE; FIELD, PS#37276; FND. T-IRON FLUSH W/ 1" ROD OVER LARGE STONE 2' E. OF C/L REESE ROAD & ON TREE LINE TO W.; RECOVERED 1 PREVIOUS WITNESS WHICH INDICATES THAT FND. T-IRON IS IN SAME POSITION AS 1968 CPCO SURVEY CITED IN SECTION A. ABOVE

ACCEPTED FND. T-IRON AS A CAREFUL AND FAITHFUL PERPETUATION OF THE ORIGINAL CORNER POSITION

C. Description of monument for corner and accessories established to perpetuate locating the position of the corner:
M-6 REPLACED FND. T-IRON AND ROD W/ 5/8" ROD & STD. REMON. CAP IN MON. BOX
NORTH, 204.08' T-IRON
N29°E, 22.11' 1/2" ROD W/CAP #37276
S22°E, 26.98' 1/2" ROD W/CAP #37276
S25°W, 39.51' 1/2" ROD W/CAP #37276
N39°W, 29.03' 1/2" ROD W/CAP #37276

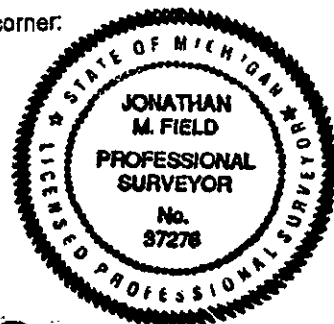

Signed by Jonathan M. Field
Surveyor's Michigan License No. 37276

Date 9-25-97

FORM APPROVED BY MICHIGAN STATE BOARD OF LAND SURVEYORS, JAN. 28, 1971
REVISED MAY 14, 1975
REVISED JAN., 1983
ADAPTED FOR WORD PROCESSING MARCH, 1993

SURVEY &
REMONUMENTATION

MAR 18 1998

SECTION