

APPROVED BY PEER GROUP
P.A. 345 OF 1990
SAGINAW COUNTY
1997 REMONUMENTATION PROGRAM
LAND CORNER RECORDATION CERTIFICATE
Filing Requirement of Act 74, Mich. P.A. 1970

RECORDED/FILED
LIBER 2028 PAGE 437
1997 OCT -3 A 8:28

MILDRED H. DODAK
REGISTER OF DEEDS
SAGINAW COUNTY, MI.

For corners in: FRANKENMUTH TWP.

<u>SAGINAW</u> (County)	Located In:	Corner Code #
1. Public Land Survey	T <u>11N</u> R <u>06E</u>	<u>M-9</u>
	T _____ R _____	_____
	T _____ R _____	_____
	T _____ R _____	_____
2. Property Controlling in Section	S _____ T _____ R _____	_____
	S _____ T _____ R _____	_____
3. Miscellaneous Property in Sec.	S _____ T _____ R _____	_____
	S _____ T _____ R _____	_____

Side 7 Page 188
Register of Deeds Stamp & File Number

4. Lot No. _____ Recorded Plat _____
5. Private Claims _____

	A	B	C	D	E	F	G	H	I	J	K	L	M
1													
2	6	5	4	3	2	1							
3													
4	7	8	9	10	11	12							
5													
6	18	17	16	15	14	13							
7													
8	19	20	21	22	23	24							
9													
10	30	29	28	27	26	25							
11													
12	31	32	33	34	35	36							
13													

I, JONATHAN M. FIELD, in a field survey on JULY 8 19 97, do hereby certify that under requirements of P.A. 74, Michigan P.A. of 1970, the corner points mentioned in lines 1 and 2 above were in conformance with regulations and rules therefore as required in the current manual of survey instructions of the United States Department of the Interior, Bureau of Land Management or by a decree of a Court of Law and/or that the corner points mentioned in lines 3, 4 and 5 above were in conformance with the rules of the Michigan Board of Land Surveyors or by a Decree of a Court of Law; established, re-established, monumented, re-monumented, recovered, found as expressed below:


NOTE: Not more than 4 corners, all in the same town and range, may be recorded on this certificate.

A. Description of original monument and accessories and/or subsequent restoration:
1821 GLO; WAMPLER, D.S.; NOT SET; "BALANCE OF THIS MILE & SEC. 24 & 13 & PART OF 12 IN RESERVATION"
1839 GLO; MULLETT, D.S.; SET POST; BEECH 12 N60W 21LKS., BEECH 7 S35W 23LKS.
1968 CPCO; BOLDT; FND. A-9 T11N-R7E ???.'?' (DIST. UNREADABLE) N. OF M-9 T11N-R6E
1974 MARTIN, LS#4699; LCRC L.3, PG. 29; T-BAR; N. 74.90' C/L JOINT, SE 32.40' P.POLE, NE 21.55' ST. SIGN POST, NW 43.00' SW COR. CONC. HEADWALL
1980 LEACH ENG.; LEACH, LS#7236; SURVEY L.1592, PG.746-7; NO OBJECT STATED; SAME WITS AS 1974 LCRC ABOVE
1986 R/C ENG.; FERGUSON, LS#26454; SURVEY L.1699, PG.1445-8; T-BAR; SAME WITS AS 1974 LCRC ABOVE
1989 SPICER ENG.; PREVOST, LS#24612; SURVEY L.591, PG.1105-1106; SHOWS M-9 T11N-R6E 181.60' S. OF A-9 T11N-R7E; NO OBJECT STATED FOR M-9; NO WITS GIVEN

B. Description of corner evidence found and/or method applied in restoring or reestablishing corner.
1997 ROWE; FIELD, PS#37276; FND. BOAT SPIKE AT C/L REESE ROAD & C/L JUNCTION ROAD TO W.; RECOVERED 3 PREVIOUS WITNESSES WHICH INDICATE THAT FND. BOAT SPIKE IS IN SAME POSITION AS 1974 MARTIN LCRC CITED IN SECTION A. ABOVE

ACCEPTED FND. BOAT SPIKE AS A CAREFUL AND FAITHFUL PERPETUATION OF THE ORIGINAL CORNER POSITION

C. Description of monument for corner and accessories established to perpetuate locating the position of the corner:
M-9 REPLACED FND. BOAT SPIKE W/ 5/8" ROD & STD. REMON. CAP
NORTH, 181.70' 1" PIPE
NORTH, 74.98' C/L JOINT IN PAVEMENT
N17°E, 35.78' W. EDGE OF STOP SIGN POST
N39°W, 43.11' SW CORNER OF CONC. HEADWALL
S66°E, 32.30' NAIL W/DISK IN SW FACE P.POLE
S31°E, 56.68' NAIL W/DISK IN NE FACE GUY POLE

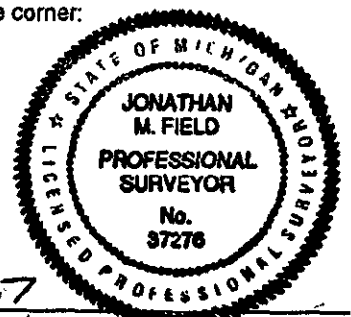

Signed by Jonathan M. Field
Surveyor's Michigan License No. 37276

Date 9-25-97

FORM APPROVED BY MICHIGAN STATE BOARD OF LAND SURVEYORS, JAN. 28, 1971

REVISED MAY 14, 1971
REVISED JAN. 1971
ADAPTED FOR WORD PROCESSING MARCH, 1971

SURVEY &
REMONUMENTATION

MAR 18 1998

SECTION