

APPROVED BY PEER GROUP
P.A. 345 OF 1990
SAGINAW COUNTY

1997 REMONUMENTATION PROGRAM
LAND CORNER RECORDATION CERTIFICATE
Filing Requirement of Act 74, Mich. P.A. 1970

RECORDED/FILED

LIBER 2028 PAGE 434

1997 OCT -3 A 8: 28

MILORED M. DOOAK
REGISTER OF DEEDS
SAGINAW COUNTY, MI.

Lib 7 Page 179
Register of Deeds Stamp & File Number

For corners in: FRANKENMUTH TWP.

SAGINAW (County)	Located In:	Corner Code #
1. Public Land Survey	T 11N R 06E	M-12
	T _____ R _____	_____
	T _____ R _____	_____
	T _____ R _____	_____
2. Property Controlling in Section	S _____ T _____ R _____	_____
	S _____ T _____ R _____	_____
3. Miscellaneous Property in Sec.	S _____ T _____ R _____	_____
	S _____ T _____ R _____	_____
4. Lot No. _____	Recorded Plat _____	
5. Private Claims _____		

	A	B	C	D	E	F	G	H	I	J	K	L	M
1													
2	6	5	4	3	2	1							
3													
4	7	8	9	10	11	12							
5													
6	18	17	16	15	14	13							
7													
8	19	20	21	22	23	24							
9													
10	30	29	28	27	26	25							
11													
12	31	32	33	34	35	36							
13													

I, JONATHAN M. FIELD, in a field survey on JULY 8 1997, do hereby certify that under requirements of P.A. 74, Michigan P.A. of 1970, the corner points mentioned in lines 1 and 2 above were in conformance with regulations and rules therefore as required in the current manual of survey instructions of the United States Department of the Interior, Bureau of Land Management or by a decree of a Court of Law and/or that the corner points mentioned in lines 3, 4 and 5 above were in conformance with the rules of the Michigan Board of Land Surveyors or by a Decree of a Court of Law; established, re-established, monumented, re-monumented, recovered, found as expressed below.

NOTE: Not more than 4 corners, all in the same town and range, may be recorded on this certificate.

A. Description of original monument and accessories and/or subsequent restoration:

- 1821 GLO; WAMPLER, D.S.; SET 1/4 SEC. POST; ELM 23 S72E 4LKS., BEECH 14 N82W 40LKS.
- 1958 BLACK, LS#3384; WIT CARD FOR A-12 T11N-R7E SHOWS NORTH 29.42' TO SAGINAW CO. 1/4 LINE TO WEST
- 1968 CPCO; BOLDT; SURVEY IN SEC. 31 T11N-R7E; SHOWS DIST. OF 29.00' TO M-12 T11N-R6E
- 1978 PREVOST, LS#24612; LCRC TUSCOLA TWP. PG.38; SET A-12 T11N-R7E; TIE OF SOUTH 34.00' TO 3/4" IRON BAR AT M-12 T11N-R6E
- 1980 SPICER ENG.; MARTIN, LS#4699; SURVEY L.505, PG.132-133; WITS FOR A-12 T11N-R7E SHOW TIE OF SOUTH 29.00' TO 3/4" BAR AT M-12 T11N-R6E
- 1981 DUNTON, LS#23503; SURVEY L.515, PG.940-941; M-12 T11N-R6E SHOWN 29.00' S. OF A-12 T11N-R7E; NO OBJECTS STATED; NO WITS GIVEN
- 1981 LEACH, LS#7236; LCRC L.5, PG.151; FND. 3/4" ROD; NORTH 29.00' ROD AT A-12 T11NR-7E, N40E 44.15' POST, WEST 23.65' POST


B. Description of corner evidence found and/or method applied in restoring or reestablishing corner:

- 1997 ROWE; FIELD, PS#37276; FND. 3/4" ROD AT C/L REESE ROAD; RECOVERED 3 PREVIOUS WITNESSES WHICH INDICATE THAT FND. ROD IS IN SAME POSITION AS 1981 LEACH LCRC CITED IN SECTION A. ABOVE

ACCEPTED FND. ROD AS A CAREFUL AND FAITHFUL PERPETUATION OF THE ORIGINAL CORNER POSITION

C. Description of monument for corner and accessories established to perpetuate locating the position of the corner:

- M-12 REPLACED FND. ROD W/ 5/8" ROD & STD. REMON. CAP
- NORTH, 29.10' 3/4" ROD
- N45°E, 44.39' 4" PIPE
- N10°W, 66.13' 1/2" ROD W/CAP #37276
- WEST, 23.85' P-K NAIL W/TAG #37276 IN N. FACE POST
- N10°E, 66.20' 1/2" ROD W/CAP #37276

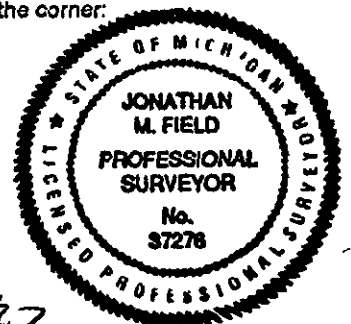

Signed by Jonathan M. Field Date 9-25-97

Surveyor's Michigan License No. 37276

SURVEY & REMONUMENTATION
FORM APPROVED BY MICHIGAN STATE BOARD OF LAND SURVEYORS, JAN. 28, 1993

REVISED MAY 14, 1993
REVISED JAN. 1993
ADAPTED FOR WORD PROCESSING MARCH, 1993

MAR 18 1998

SECTION