

APPROVED BY PEER GROUP
P.A. 345 OF 1990
SAGINAW COUNTY

1996 SAGINAW COUNTY REMONUMENTATION
LAND CORNER RECORDATION CERTIFICATE
Filing Requirement of Act 74, Mich. P.A. 1970

3-6-96

[Signature]

For corners in Thomas Township

LIBER 1985 PAGE 1456

Lib 7 Page 54

Saginaw (County)	Located In:	Corner Code #
1. Public Land Survey	T 12N R 3E T 12N R 3E T _____ R _____ T _____ R _____	<u>B-3</u> C-3
2. Property Controlling in Section	S _____ T _____ R _____ S _____ T _____ R _____	
3. Miscellaneous Property in Sec.	S _____ T _____ R _____ S _____ T _____ R _____	

HILDRED M. DODAK
 REGISTER OF DEEDS
 SAGINAW COUNTY MICH.

SEP 23 11 34 AM 1996

RECORDED & FILED

Register of Deeds Stamp & File Number

4. Lot No. _____, Recorded Plat _____
5. Private Claims _____

I, Ronald C. Prevost, in a field survey on 1-31, 1996 do hereby state that under requirements of P.A. 74, Michigan P.A. of 1970, the corner points mentioned in lines 1 and 2 above were in conformance with regulations and rules therefore as required in the current manual of survey instructions of the United States Department of the Interior, Bureau of Land Management or by a decree of a Court of Law and /or that the corner points mentioned in lines 3, 4 and 5 above were in conformance with the rules of the Michigan Board of Land Surveyors or by a Decree of a Court of Law; established, re-established, monumented, recovered, found as expressed below:

NOTE: Not more than 2 corners, all in the same town and range, may be recorded on this certificate.

A	B	C	D	E	F	G	H	I	J	K	L
1											
2	6	5			4		3		2		1
3	•	•									
4	7	8			9		10		11		12
5											
6	10	17			16		15		14		13
7											
8	19	20			21		22		23		24
9											
10	30	29			28		27		26		25
11											
12	31	32			33		34		35		36
13											

A. Description of original monument and accessories and/or subsequent restoration:

- | | |
|--|--|
| <p>B-3 Post By Wampler 1822
 Beech 9 N.55 1/2° E. 7 L
 Beech 14 N.87 1/2° W 19 L
 Nail set by Spicer Engineering Co. 1964
 LCRC L2 P136, Nail, Soltis, 1973
 SCRC record 1" pipe, 1975
 LCRC L1632 P2021, 3/4" pipe, Prevost, 1983
 Recorded survey Soltis L1388 P950, 1973
 Recorded survey Ledy L1921 P2283, 1994</p> | <p>C-3 Post By Wampler 1822
 Maple 7 S 10 W 8 1/2 L
 Maple 9 N 26 W 17 L
 RR spike set by Spicer Engineering Co. 1958
 SCRC record 5/8" pipe 1968
 SCRC record 3/4" pipe 1972, placed mon box
 LCRC L1 P155 3/4" pipe, McKelvey, 1972
 Recorded surveys L1358 P1299, L1368 P895, L1386 P729, L1446 P682,
 L1597 P217, L1921 P2283</p> |
|--|--|

B. Description of corner evidence found and/or method applied in restoring or reestablishing corner:


- | | |
|--|--|
| <p>B-3 Found 3/4" pipe with witnesses
 N. 27.73 to face P. Pole (M27.81)
 N. 33.00 3/4" iron pipe (M33.00)
 S. 10° E 71.20 nail NW face 24" Poplar (M71.10)
 Accepted by Peer Review Group 3-6-96
 Position accepted as best available evidence of original corner.</p> | <p>C-3 Found 3/4" pipe in mon box with witness
 NE 37.30 face Tel Pole (M37.37)
 NE 37.85 sur disk in U. Pole (M37.85)
 SE 39.75 face of rd sign (M39.98)
 SE 45.3 Hyd (M45.13)
 Accepted by Peer Review Group 3-6-96
 Position accepted as best available evidence of original corner.</p> |
|--|--|

C. Description of monument for corner and accessories established to perpetuate locating the position of the corner:

- | | |
|--|--|
| <p>B-3 Set mon box with 5/8" bar & Sag. Co. Remon
 Cap in place of 3/4" pipe 3-21-96
 N.02°E. 27.81 nail & cap E side P. Pole
 North 33.00 3/4" pipe
 S.10°E. 71.10 nail in W face 36" Poplar
 N.30°W. 34.38 Ctr. Hyd.
 S.45°W. 55.22 nail Rt. side 12" Maple</p> | <p>C-3 Set 5/8" Bar & Sag. Co. Remon Cap
 In place of 3/4" pipe in existing mon box & new cover 3-22-96
 S.30°E. 63.92 nail & cap Rt. Side P. Pole
 S.40°E. 45.13 Ctr. Hyd.
 N.45°E. 37.85 R/S disk in Util. Pole
 S.25°W. 130.43 Nail & Cap Rt. Side P. Pole</p> |
|--|--|

Signed by Ronald C. Prevost
 Surveyor's Michigan License No. 24612

Date 9-20-96

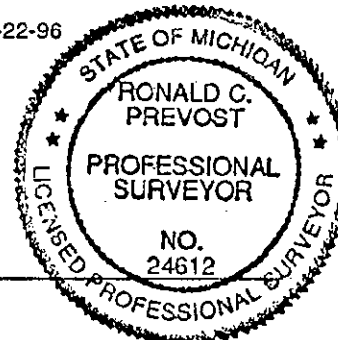

SURVEY &
REMONUMENTATION

MAY 16 1997

COMMISSION