

SAGINAW COUNTY REMONUMENTATION

LAND CORNER RECORDATION CERTIFICATE

Filing Requirement of Act 74, Mich. P.A. 1970

*Lib 7 Page 21*

*12/13/95 BFB*

For corners in  
Saginaw  
(County)

Located In: THOMAS TWP. Corner Code #

1. Public Land Survey	T	12	R	3E	B-11
	T		R		
	T		R		
	T		R		
2. Property Controlling in Section	S		T	R	
	S		T	R	
3. Miscellaneous Property in Sec.	S		T	R	
	S		T	R	

RECORDED & FILED  
Dec 28 12 35 PM '95  
REGISTERED DEEDS  
SAGINAW COUNTY MICH.

Register of Deeds Stamp & File Number

4. Lot No. \_\_\_\_\_, Recorded Plat \_\_\_\_\_  
5. Private Claims \_\_\_\_\_

	A	B	C	D	E	F	G	H	I	J	K	L	M
2	6		5		4		3		2		1		
3													
4	7		8		9		10		11		12		
5													
6	18		17		16		15		14		13		
7													
8	19		20		21		22		23		24		
9													
10	30		29		28		27		26		25		
11													
12	31		32		33		34		35		36		
13													

I, Duane F. Ledy, in a field survey on December 6, 19 95, do hereby certify that under requirements of P.A. 74, Michigan P.A. of 1970, the corner points mentioned in lines 1 and 2 above were in conformance with regulations and rules therefore as required in the current manual of survey instructions of the United States Department of the Interior, Bureau of Land Management or by a decree of a Court of Law and/or that the corner points mentioned in lines 3, 4 and 5 above were in conformance with the rules of the Michigan Board of Land Surveyors or by a Decree of a Court of Law; established, re-established, monumented, re-monumented, recovered, found as expressed below:

**NOTE: Not more than 4 corners, all in the same town and range, may be recorded on this certificate.**

A. Description of original monument and accessories and/or subsequent restoration:

Set post 40 chains west of C-11; J. Wampler, 1822  
14" Sugar - S 81°E, 27 links  
7" Beech - S 50°W, 10.5 links  
Spicer Engineering recorded a 3/4" pipe at fence lines N. S. E. & W. in L.C.R.C., L5, p43. Also noted that position and pipe used since 1954. No records available of restoration previous to 1954.

CORNER  
REMONUMENTATION

FEB 22 1996


COMMISSION

B. Description of corner evidence found and/or method applied in restoring or reestablishing corner:

Found 3/4" pipe with cap no. 24612 at intersection of fence lines.  
Also found 3/4" pipe 0.15' South and 0.54' East, no cap.  
Witnesses found:  
S 45°W - 31.15' Face 6" White Pine (M 31.0' 10" White Pine)  
  
Existing capped pipe accepted as best available evidence of the position of the original corner.

C. Description of monument for corner and accessories established to perpetuate locating the position of the corner:

Placed 5/8" rod with 2 1/2" Saginaw County brass cap over 3/4" pipe. Set in monument box.  
S 10°E - 16.90' to Nail & Tag in West side of 12" Oak  
East - 23.05' to Nail & Tag in North side of 10" Oak  
North - 10.40' to Nail & Tag in West side of 10" Poplar  
S 80°W - 31.95' to Nail & Tag in North side of 10" White Pine

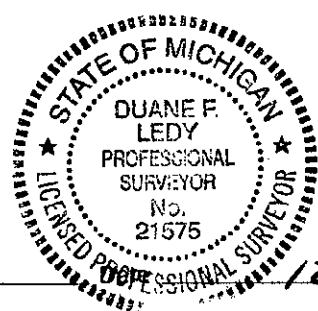

Signed by Duane F. Ledy  
Surveyor's Michigan License No. 21575

12-22-95