

B-20-96 *BRF*

For corners in Thomas Township

Saginaw (County)	Located In:	Corner Code #
1. Public Land Survey	T <u>12 N.</u> R <u>3 E.</u>	<u>C-2</u>
	T ___ R ___	_____
	T ___ R ___	_____
	T ___ R ___	_____
2. Property Controlling in Section	S ___ T ___ R ___	_____
	S ___ T ___ R ___	_____
3. Miscellaneous Property in Sec.	S ___ T ___ R ___	_____
	S ___ T ___ R ___	_____

RECORDED & FILED
SEP 23 11 34 AM 1996
MILDRED H. DODAK
REGISTER OF DEEDS
SAGINAW COUNTY MICH.
Liber 7 Page 49
Register of Deeds Stamp & File Number

4. Lot No. _____, Recorded Plat _____
5. Private Claims _____

I, Ronald C. Prevost, in a field survey on 1-31, 1996 do hereby state that under requirements of P.A. 74, Michigan P.A. of 1970, the corner points mentioned in lines 1 and 2 above were in conformance with regulations and rules therefore as required in the current manual of survey instructions of the United States Department of the Interior, Bureau of Land Management or by a decree of a Court of Law and /or that the corner points mentioned in lines 3, 4 and 5 above were in conformance with the rules of the Michigan Board of Land Surveyors or by a Decree of a Court of Law; established, re-established, monumented, recovered, found as expressed below:

	A	B	C	D	E	F	G	H	I	J	K	L	M
1													
2		6	●	5		4		3		2		1	
3													
4		7		8		9		10		11		12	
5													
6		18		17		16		15		14		13	
7													
8		19		20		21		22		23		24	
9													
10		30		29		28		27		26		25	
11													
12		31		32		33		34		35		36	
13													


NOTE: Not more than 2 corners, all in the same town and range, may be recorded on this certificate.

A. Description of original monument and accessories and/or subsequent restoration:
C-2 Post set by Wampler, 1822
3/4" Pipe set by Spicer Eng. 1974, Martin
L.C.R.C. L3 P76, 1974 Martin 3/4" pipe
1/2" rod set by Wade-Trim\Edmands, No witnesses, no date. 2633.2 North of corner C-3

B. Description of corner evidence found and/or method applied in restoring or reestablishing corner:
C-2 Found 3/4" pipe as per LCRC L3 P76, found no other points.
South 2632.60 to corner C-3 (2633.0 SEC 1974)(2633.2 WT/ED)
SW 123.82 NE cor. block fnd'n house (123.83R)
SW 143.16 R.R. spike E. face P. Pole (142.74 to face R)
Location accepted by Peer Review Group 8-20-96 as the best available evidence of the original government corner.

C. Description of monument for corner and accessories established to perpetuate locating the position of the corner:
C-2 Set 5/8" Bar & Saginaw County Re-Mon Cap in place of 3/4" pipe & placed Mon Box 9-96.
N.30°W. 181.25 nail & cap rt. side P. Pole.
N.89°W. 74.80 nail & cap rt. side 16" Maple
S.25°W. 143.16 R.R. spike E face P. Pole
S.45°W. 123.82 NE cor. block fndn house.
S.30°W. 39.88 found P.K. nail in top fence post.

Signed by Ronald C. Prevost Date 9-20-96

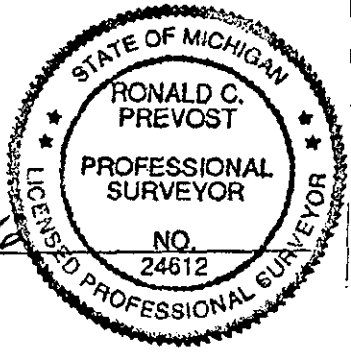

Surveyor's Michigan License No. 24612

SURVEY &
REMONUMENTATION
MAY 16 1997
COMMISSION