

Liber 7 Page 116

APPROVED BY PEER GROUP
P.A. 345 OF 1990

SAGINAW COUNTY

SAGINAW COUNTY REMONUMENTATION

LAND CORNER RECORDATION CERTIFICATE

Filing Requirement of Act 74, Mich. P.A. 1970

For corners in

THOMAS TWP.

Saginaw

(County)

Located In:
Thomas Twp.

Corner Code #

1. Public Land Survey

T12N	R 3E	D-5
T12N	R 3E	D-7
T	R	
T	R	
S	T	R
S	T	R
S	T	R
S	T	R

2. Property Controlling in Section

3. Miscellaneous Property in Sec.

MILDRED H. DODAK
 REGISTER OF DEEDS,
 SAGINAW COUNTY HIGH.

OCT 31 2 25 PM 1996

RECORDED & FILED

Register of Deeds Stamp & File Number

4. Lot No. _____, Recorded Plat _____
5. Private Claims _____

I, Duane F. Ledy, in a field survey on October 16, 1996 do hereby state that under requirements of P.A. 74, Michigan P.A. of 1970, the corner points mentioned in lines 1 and 2 above were in conformance with regulations and rules therefore as required in the current manual of survey instructions of the United States Department of the Interior, Bureau of Land Management or by a decree of a Court of Law and /or that the corner points mentioned in lines 3, 4 and 5 above were in conformance with the rules of the Michigan Board of Land Surveyors or by a Decree of a Court of Law, established, re-established, monumented, recovered, found as expressed below:

NOTE: Not more than 2 corners, all in the same town and range, may be recorded on this certificate.

	A	B	C	D	E	F	G	H	I	J	K	L	M
1													
2	6			5			4			3			2
3													
4	7			8			9			10			11
5													
6	18			17			16			15			14
7													
8	19			20			21			22			23
9													
10	30			29			28			27			26
11													
12	31			32			33			34			35
13													

A. Description of original monument and accessories and/or subsequent restoration:

D-5
 Set post at 39.22 chains West of E-5; 1822, Joseph Wampler
 5" Sugar-N75°W, 4 links
 20" Elm-S29°E, 17 links
 L.C.R.C.-Martin (L1, P110) 1971 & Surveys (L1341, P586-L1446, P682- L1468, P209- L1512, P63) All call for 3/4" Pipe and same witnesses.

D-7
 Set post at 39.65 chains West of E-7; 1822, Joseph Wampler
 20" Pine-N66°W, 11 links
 20" Pine-S72°E, 13 links
 No L.C.R.C. or Surveys recorded.

B. Description of corner evidence found and/or method applied in restoring or reestablishing corner:

D-5 Found 3/4" Pipe in Mon. box 3.5' North of C.L. Bit.
 Distance fits well bet. D-5 & C-5 per L1512, P63-L1468, P209-L1446, P682.
 1/4 mile dist. also fits bet. D-5 & E-5 per L1341, P586.

D-7
 Found 3/4" pipe w/cap #4699 at fence corner
 Fits well with unrecorded surveys by Ledy and Prevost.

Monument accepted as best evidence of original position.

Monument accepted as best evidence of original position.


C. Description of monument for corner and accessories established to perpetuate locating the position of the corner:

D-5
 Set 5/8" with remon cap over 3/4" pipe in monument box.
 SSW 13.85' to centerline water box
 SE 160.34' to set nail in SW side 14" tree clump
 NE 236.60' to set N&T in N side P.P.
 SW 262.53' to NE cor. Hse. #11561
 S 3.5' to centerline bit.

D-7
 Set 5/8" rod with remon cap over 3/4" pipe.
 NW 18.38' to nail & tag in East side 5" Poplar
 SW 15.89' to nail & tag in SE side 5" Oak
 East 33.25' to nail & tag in North side 15" Maple
 NNW 8.85' to nail & tag in South side 6" Maple
 NW 0.35' to centerline Dow sign post.

Signed by Duane F. Ledy
Surveyor's Michigan License No. 21575

Date 10/31/96

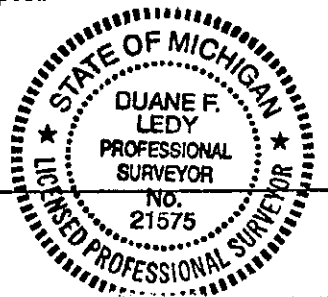

MAY 16 1997