

APPROVED BY PEER GROUP SAGINAW COUNTY REMONUMENTATION

P.A. 345 OF 1990

SAGINAW COUNTY

LIBER 1956 PAGE 1121

LAND CORNER RECORDATION CERTIFICATE

Filing Requirement of Act 74, Mich. P.A. 1970

Lib 7 Page 30

9/28/95 [Signature]

Thomas Twp. Corner Code #

For corners in Saginaw

(County)

Located In:

		12 N. 3 E.	D-9
1. Public Land Survey	T	_____ R _____	_____
	T	_____ R _____	_____
	T	_____ R _____	_____
	T	_____ R _____	_____
2. Property Controlling in Section	S	_____ T _____ R _____	_____
	S	_____ T _____ R _____	_____
3. Miscellaneous Property in Section	S	_____ T _____ R _____	_____
	S	_____ T _____ R _____	_____


RECORDED & FILED
SAGINAW COUNTY, MICH.

DEC 28 12 36 PM '95

RECORDED & FILED

Register of Deeds Stamp & File Number

4. Lot No. _____, Recorded Plat _____
5. Private Claims _____

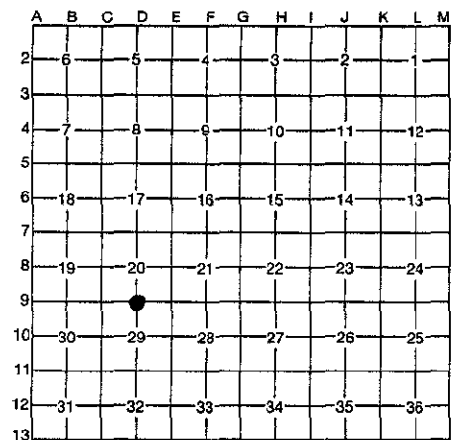

Ronald C. Prevost Nov. 29 95

I, _____, in a field survey on _____, 19____, do hereby certify that under requirements of P.A. 74, Michigan P.A. of 1970, the corner points mentioned in lines 1 and 2 above were in conformance with regulations and rules therefore as required in the current manual of survey instructions of the United States Department of the Interior, Bureau of Land Management or by a decree of a Court of Law and/or that the corner points mentioned in lines 3, 4 and 5 above were in conformance with the rules of the Michigan Board of Professional Surveyors or by a Decree of a Court of Law; established, re-established, monumented, re-monumented, recovered, found as expressed below:

NOTE: Not more than 4 corners, all in the same town and range, may be recorded on this certificate.

A. Description of original monument and accessories and/or subsequent restoration:

D-9 Post Set by Wampler, 1822
Fence corner accepted by J.W. Martin (Spicer) 1973, concrete plat monument set.
Recorded survey L1433 P721

B. Description of corner evidence found and/or method applied in restoring or reestablishing corner:

D-9 Found concrete plat monument, as per Spicer notes of 1973.
Is accepted as the best available evidence of the position of the original corner. Ratified by Saginaw Co. Peer Group 11-29-95

REMONUMENTATION

FEB 22 1996

COMMISSION

C. Description of monument for corner and accessories established to perpetuate locating the position of the corner:

D-9 Replaced concrete plat monument with 3" x 36" steel pipe filled with concrete with 5/8" Re-rod and Saginaw Co. Brass Cap. 12-4-95
N.40°E. 27.10 Nail & Cap Face 30" Maple.
N.10°W. 45.20 Nail & Cap Face 24" Oak.
S.65°E. 38.00 Nail & Cap Face 24" Oak.
South 37.34 Nail & Cap Face 15" Maple.



Signed by [Signature] Surveyor's Michigan License No. 24612

Date 12-27-95