

8-20-96 BOP
For corners in Thomas Township

| Saginaw (County) | Located In: | Corner Code # |
|---------------------------------------|----------------|---------------|
| 1. Public Land Survey | T 12 N. R 3 E. | E-4 |
| | T R | |
| | T R | |
| | T R | |
| 2. Property Controlling in Section | S T R | |
| | S T R | |
| 3. Miscellaneous Property in Sec. | S T R | |
| | S T R | |

RECORDED & FILED
SEP 23 11 34 AM 1996
MILDRED M. DODAK,
REGISTER OF DEEDS
SAGINAW COUNTY MICH.
Liber 7 Page 51
Register of Deeds Stamp & File Number

4. Lot No. _____, Recorded Plat _____
5. Private Claims _____

I, Ronald C. Prevost, in a field survey on 1-31, 19 96 do hereby state that under requirements of P.A. 74, Michigan P.A. of 1970, the corner points mentioned in lines 1 and 2 above were in conformance with regulations and rules therefore as required in the current manual of survey instructions of the United States Department of the Interior, Bureau of Land Management or by a decree of a Court of Law and/or that the corner points mentioned in lines 3, 4 and 5 above were in conformance with the rules of the Michigan Board of Land Surveyors or by a Decree of a Court of Law; established, re-established, monumented, recovered, found as expressed below:

NOTE: Not more than 2 corners, all in the same town and range, may be recorded on this certificate.

| | A | B | C | D | E | F | G | H | I | J | K | L | M |
|----|---|----|---|----|---|----|---|----|---|----|---|----|---|
| 1 | | | | | | | | | | | | | |
| 2 | | 6 | | 5 | | 4 | | 3 | | 2 | | 1 | |
| 3 | | | | | | | | | | | | | |
| 4 | | 7 | | 8 | ● | 9 | | 10 | | 11 | | 12 | |
| 5 | | | | | | | | | | | | | |
| 6 | | 18 | | 17 | | 16 | | 15 | | 14 | | 13 | |
| 7 | | | | | | | | | | | | | |
| 8 | | 19 | | 20 | | 21 | | 22 | | 23 | | 24 | |
| 9 | | | | | | | | | | | | | |
| 10 | | 30 | | 29 | | 28 | | 27 | | 26 | | 25 | |
| 11 | | | | | | | | | | | | | |
| 12 | | 31 | | 32 | | 33 | | 34 | | 35 | | 36 | |
| 13 | | | | | | | | | | | | | |

A. Description of original monument and accessories and/or subsequent restoration:

E-4 Post set by Wampler 1822
RR spike found, 1967, Spicer Eng. Co.
RR spike found, 1968 S.C.R.C.
LCRC L3 P17 RR spike fnd. Leach, 1974
Recorded survey RR spike, 1980 Ferguson
Recorded survey L 1761 P 2289 RR spike, 1989, Ferguson

B. Description of corner evidence found and/or method applied in restoring or reestablishing corner:

E-4 Found RR spike
SW 149.57 (149.71 R)(Spicer 1967) Face P & T Pole
North to E-3 = 2626.61 Calc. (2626.56 Spicer previous)
South to E-5 = 2622.55 Meas'd (2622.51 & 2622.60 Spicer previous)
Location accepted by Peer Review Group 8-20-96 as the best available evidence of the original government corner


C. Description of monument for corner and accessories established to perpetuate locating the position of the corner:

E-4 Replace RR spike with 5/8" bar & Saginaw County Re-Mon Cap
Place Mon. Box 9-96
N.60°W. 108.38 SE cor. brick house #3517
N.65°E. 53.12 nail & cap W face 14" Poplar
N.60°W. 65.10 face 12" Maple in yard
West 41.33 gasoline marker
S.25°W. 149.57 nail in E face P. Pole

Signed by Ronald C. Prevost

Date 9-20-96

Surveyor's Michigan License No. 24612

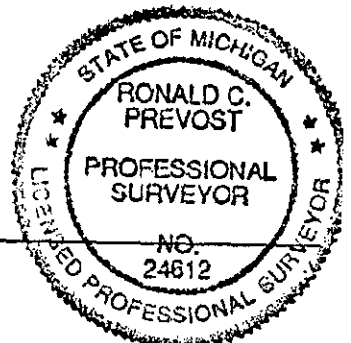

MAY 16 1997

COMMISSION