

APPROVED BY PEER GROUP **SAGINAW COUNTY REMONUMENTATION**

P.A. 345 OF 1990

LIBER 1956 PAGE 1122

SAGINAW COUNTY

LAND CORNER RECORDATION CERTIFICATE

Filing Requirement of Act 74, Mich. P.A. 1970

9/28/95 *RCP*

THOMAS TWP.

For corners in Saginaw

Located In:

Corner Code #

(County)

		12 N.	3 E.	E-9
1. Public Land Survey	T	_____	R	_____
	T	_____	R	_____
	T	_____	R	_____
	T	_____	R	_____
2. Property Controlling in Section	S	_____	T	R
	S	_____	T	R
3. Miscellaneous Property in Section	S	_____	T	R
	S	_____	T	R

4. Lot No. _____, Recorded Plat _____
 5. Private Claims _____

Ronald C. Prevost

Nov. 29

95

I, _____, in a field survey on _____, 19 _____, do hereby certify that under requirements of P.A. 74, Michigan P.A. of 1970, the corner points mentioned in lines 1 and 2 above were in conformance with regulations and rules therefore as required in the current manual of survey instructions of the United States Department of the Interior, Bureau of Land Management or by a decree of a Court of Law and/or that the corner points mentioned in lines 3, 4 and 5 above were in conformance with the rules of the Michigan Board of Professional Surveyors or by a Decree of a Court of Law; established, re-established, monumented, re-monumented, recovered, found as expressed below:

NOTE: Not more than 4 corners, all in the same town and range, may be recorded on this certificate.

A. Description of original monument and accessories and/or subsequent restoration:

E-9 Post Set by Wampler, 1822
 L.C.R.C. L1, P145, Iron Rod, 1971, Sides
 L.C.R.C. L4, P54, 1/2" Rod, 1977, Martin
 Recorded surveys L1506 P151, L1385 P555, L1400 P276, L1433 P721, L1433 P723
 Location of E-9 established by J.W. Martin in 1947 by extension of E.1/4 Cor. and N.1/8 Cor. on E. Line Sec. 29 at double the distance, (2617.04)
 Notes not clear if a point was set.

B. Description of corner evidence found and/or method applied in restoring or reestablishing corner:

E-9 Found 5/8" rod in mon. box.
 2632.71 West to D-9 (2632.36 R)
 2616.61 South to E-10 (2617.04 R MDOT)
 Is accepted as the best available evidence of the position of the original corner. Ratified by Saginaw Co. Peer Group 11-29-95


C. Description of monument for corner and accessories established to perpetuate locating the position of the corner:

E-9 Placed Saginaw Co. Brass Cap on existing 5/8" Rod in existing mon. box. 11-5-95.
 S.85°E. 26.44 Ctr. Hyd.
 S.20°W. 188.60 Nail & Cap Face P. Pole.
 N.20°E. 122.90 Nail & Cap Face 40" Oak.
 N.20°W. 94.43 Nail & Cap Face 36" Maple.

Like 7 Page 31

RECORDED & FILED
 DEC 28 12 36 PM '95
 REGISTER OF DEEDS
 SAGINAW COUNTY MICH.

Register of Deeds Stamp & File Number

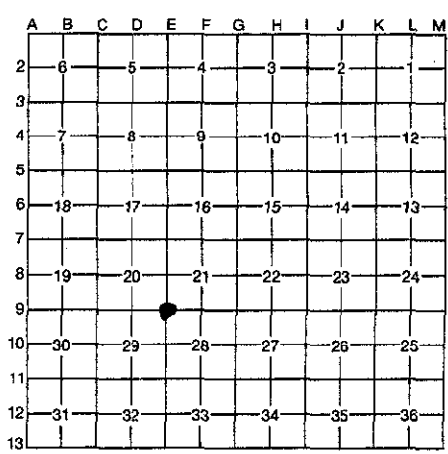

REMONUMENTATION
 FEB 2 2 1996
 COMMISSION



Signed by *Ronald C. Prevost*

Date 12-27-95

Surveyor's Michigan License No. 24612