

APPROVED BY PEER GROUP
P.A. 345 OF 1990
SAGINAW COUNTY

LIBER 1989 PAGE 2285

Liber 7 Page 111

SAGINAW COUNTY REMONUMENTATION
LAND CORNER RECORDATION CERTIFICATE
Filing Requirement of Act 74, Mich. P.A. 1970

For corners in

THOMAS TWP

Saginaw

(County)

Located In:
Thomas Twp.

Corner Code #

1. Public Land Survey

T12N R 3E

F-7

T12N R 3E

F-5

T R

T R

2. Property Controlling
in Section

S T R

S T R

3. Miscellaneous
Property in Sec.

S T R

S T R

MILDRED H. DODAK
REGISTER OF DEEDS
SAGINAW COUNTY MICH.
OCT 31 2 23 PM 1989

RECORDED & FILED

Register of Deeds Stamp & File Number

4. Lot No. _____, Recorded Plat _____
5. Private Claims _____

I, Duane F. Ledy, in a field survey on October 25, 1996 do hereby state that under requirements of P.A. 74, Michigan P.A. of 1970, the corner points mentioned in lines 1 and 2 above were in conformance with regulations and rules therefore as required in the current manual of survey instructions of the United States Department of the Interior, Bureau of Land Management or by a decree of a Court of Law and/or that the corner points mentioned in lines 3, 4 and 5 above were in conformance with the rules of the Michigan Board of Land Surveyors or by a Decree of a Court of Law, established, re-established, monumented, recovered, found as expressed below:

NOTE: Not more than 2 corners, all in the same town and range, may be recorded on this certificate.

	A	B	C	D	E	F	G	H	I	J	K	L	M
1													
2	6		5		4		3		2		1		
3													
4	7		8		9		10		11		12		
5						⊕							
6	18		17		16		15		14		13		
7						⊕							
8	19		20		21		22		23		24		
9													
10	30		29		28		27		26		25		
11													
12	31		32		33		34		35		36		
13													

A. Description of original monument and accessories and/or subsequent restoration:

F-7
Set post at 39.77 chains West of G-7; 1822, Joseph Wampler
9" Sugar-S71°W, 9 links
12" Sugar-S49°E, 6 links

F-5
Set post at 39.82 chains West of G-5; 1822, Joseph Wampler
40" Pine-West, 3 1/2 links
9" Beech-N3°E, 9 1/2 links

L.C.R.C. Martin (L1, P257) 1972 3/4 Pipe.
Surve-Martin (L1376, P1288) 1972 3/4" Pipe.
Survey-Ledy (L 1783, P2069) 1990 1/2 Rod in Mon Box.

L.C.R.C.-Martin (L2, P107) 1973 P.K. nail.
Survey -Martin (L1376, P1288) 1972 P.K. nail

B. Description of corner evidence found and/or method applied in restoring or reestablishing corner:

F-7 Found 1/2" Rod (leaning) in Mon. box.
L.C.R.C. & Survey by Martin witness:
E 48.44' (47.38' measured 6' high) Fce P. P.
SE 107.69' (107.35' m) to angle point on E. end of N. abutment.
Survey by Ledy witness:
NE 41.90' (41.88 m) to spike in 6" Maple
E. 47.76' (47.75' m) to P.K. nail in P.P.
SE 37.33' (37.35' m) to P.K. in Top Guard Rail Post
SW 34.50' (34.58' m) to P.K. in Top Guard Rail Post

F-5 Found 3/4" pipe in Mon box.
L.C.R.C. & Survey witness:
N 28.41' (28.60' m) Fce P. & T. P.
SE 54.42' (54.45' m) Fce P. P.
NW 73.60' (73.74' m) Ctr Fire Hyd.

Monument accepted as best evidence of original position.

Monument accepted as best evidence of original position.


C. Description of monument for corner and accessories established to perpetuate locating the position of the corner:

F-7
Set 5/8" rod with remon. cap in monument box.
SW, 34.58' to PK in top, North end guard rail post
SE, 37.35' to PK in top, North end guard rail post
East, 47.75' to PK in S side P.P.
NE, 41.88' to nail in SE side 8" Maple

F-5
Set 5/8" rod with remon. cap over 3/4" pipe in monument box.
N, 28.89' to nail & tag in P.P. 1.5' above ground
NW, 73.74' to top centerline fire hydrant
SW, 50.15' to gas pipeline marker
SE, 54.61' to nail & tag in W side P.P.
West, 30' to centerline of Lone Road to North

Signed by Duane F. Ledy
Surveyor's Michigan License No. 21575

Date _____

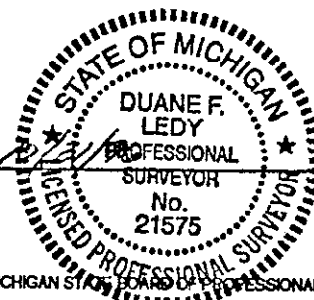

MAY 13 1987