

SAGINAW COUNTY REMONUMENTATION

LAND CORNER RECORDATION CERTIFICATE  
Filing Requirement of Act 74, Mich. P.A. 1970

B-7-96

*Liber 7 page 71*

For corners in

Saginaw Located in: Thomas Twp. Corner Code #  
(County)

1. Public Land Survey	T <u>12N</u> R <u>3E</u>	<u>G-5</u>
	T _____ R _____	_____
2. Property Controlling in Section	S _____ T _____ R _____	_____
	S _____ T _____ R _____	_____
3. Miscellaneous Property in Sec.	S _____ T _____ R _____	_____
	S _____ T _____ R _____	_____

REGISTERED & FILED  
SEP 27 11 42 AM 1986  
MILDRED N. DODAK  
REGISTER OF DEEDS  
SAGINAW COUNTY MICH.  
Register of Deeds Stamp & File Number

4. Lot No. \_\_\_\_\_, Recorded Plat \_\_\_\_\_  
5. Private Claims \_\_\_\_\_

	A	B	C	D	E	F	G	H	I	J	K	L	M
1													
2	6			5		4		3		2		1	
3													
4	7			8		9		10		11		12	
5													
6	16			17		18		19		14		13	
7													
8	10			20		21		22		23		24	
9													
10	30			29		28		27		26		25	
11													
12	31			32		33		34		35		36	
13													

I, Brian D Ferguson, in a field survey on September 3, 1996 do hereby state that under requirements of P.A. 74, Michigan P.A. of 1970, the corner points mentioned in lines 1 and 2 above were in conformance with regulations and rules therefore as required in the current manual of survey instructions of the United States Department of the Interior, Bureau of Land Management or by a decree of a Court of Law and/or that the corner points mentioned in lines 3, 4 and 5 above were in conformance with the rules of the Michigan Board of Land Surveyors or by a Decree of a Court of Law; established, re-established, monumented, recovered, found as expressed below:

NOTE: Not more than 2 corners, all in the same town and range, may be recorded on this certificate.

A. Description of original monument and accessories and/or subsequent restoration:


G-5 Wood post set by Wampler, 1822.  
LCRC L. 3, Page 17.  
Survey L. 1902, Page 477.  
Agrees with SCRC witnesses, 1973.

B. Description of corner evidence found and/or method applied in restoring or reestablishing corner:

G-5 Found 3/4" iron bar in monument box set by SCRC in 1974.  
Current position agrees with 1/2 mile distances from plats recorded in L. 21, Pg. 4 & L. 25, Pg. 6.  
Accepted by peer group as best available evidence of original corner.

C. Description of monument for corner and accessories established to perpetuate locating the position of the corner:

G-5 Set 5/8" steel bar with Saginaw County Remon. cap in monument box.  
N45°W 38.52 PK nail in NE face power pole.  
N45°E 43.41 Top ctr. hyd.  
S30°W 54.50 N & S in NW face power pole.  
S30°E 55.00 PK nail in W face power pole.

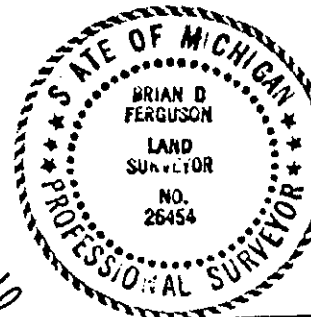

Signed by Brian D Ferguson  
Surveyor's Michigan License No. 26454

Date 9-27-96

REMONUM

MAY 13 1987

COV