

SAGINAW COUNTY REMONUMENTATION

LAND CORNER RECORDATION CERTIFICATE  
Filing Requirement of Act 74, Mich. P.A. 1970

For corners in

Saginaw Located in: Thomas Twp. Corner Code #  
(County)

1. Public Land Survey	T <u>12N</u> R <u>3E</u>	<u>H-7</u>
	T _____ R _____	_____
2. Property Controlling	S _____ T _____ R _____	_____
in Section	S _____ T _____ R _____	_____
3. Miscellaneous	S _____ T _____ R _____	_____
Property in Sec.	S _____ T _____ R _____	_____

RECORDED & FILED  
 SEP 27 11 42 AM '96  
 HILDRED M. DODAK  
 REGISTER OF DEEDS  
 SAGINAW COUNTY MICH.  
*Liber 7 Page 57*  
 Register of Deeds Stamp & File Number

4. Lot No. \_\_\_\_\_, Recorded Plat \_\_\_\_\_  
 5. Private Claims \_\_\_\_\_

I, Brian D Ferguson, in a field survey on September 3, 19 96 do hereby state that under requirements of P.A. 74, Michigan P.A. of 1970, the corner points mentioned in lines 1 and 2 above were in conformance with regulations and rules therefore as required in the current manual of survey instructions of the United States Department of the Interior, Bureau of Land Management or by a decree of a Court of Law and/or that the corner points mentioned in lines 3, 4 and 5 above were in conformance with the rules of the Michigan Board of Land Surveyors or by a Decree of a Court of Law; established, re-established, monumented, recovered, found as expressed below:

NOTE: Not more than 2 corners, all in the same town and range, may be recorded on this certificate.

1	A	B	C	D	E	F	G	H	I	J	K	L	M
2	6	5	4	3	2	1							
3													
4	7	6	5	4	3	2	1						
5													
6	18	17	16	15	14	13							
7													
8	19	20	21	22	23	24							
9													
10	30	29	28	27	26	25							
11													
12	31	32	33	34	35	36							
13													

A. Description of original monument and accessories and/or subsequent restoration:

H-7 Wood post set by Wampler, 1822.  
 LCRC L. 4, Pg. 208.  
 Reset by Spicer Engineering Co. in 1975 on split between G-7 and I-7.

B. Description of corner evidence found and/or method applied in restoring or reestablishing corner:


H-7 Found 3/4" pipe set by Spicer Engineering Co. in 1975.  
 Agrees with occupation N-S and E-W.  
 Accepted by peer group as best available evidence of original corner.

C. Description of monument for corner and accessories established to perpetuate locating the position of the corner:

H-7 Set 5/8" steel bar with Saginaw County Remon. cap.  
 N0°E 27.98 Spike S face 48" stump.  
 N90°E 33.46 Spike W face 12" maple.  
 S50°E 05.95 Spike NW face 12" poplar.  
 N85°W 19.50 Spike E face 24" stump.

Signed by Brian D Ferguson  
 Surveyor's Michigan License No. 26454

Date 9-27-96

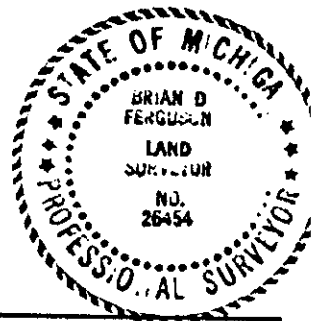

MAY 1 6 1997  
 COMMISSION