

SAGINAW COUNTY REMONUMENTATION

LAND CORNER RECORDATION CERTIFICATE
Filing Requirement of Act 74, Mich. P.A. 1970

For corners in

Saginaw Located in: Thomas Twp. Corner Code #
(County)


1. Public Land Survey	T <u>12</u> N R <u>3E</u>	<u>1-4</u>
	T _____ R _____	_____
2. Property Controlling in Section	S _____ T _____ R _____	_____
	S _____ T _____ R _____	_____
3. Miscellaneous Property in Sec.	S _____ T _____ R _____	_____
	S _____ T _____ R _____	_____

Liber 7 Page 68

REGISTERED & FILED
SEP 27 11 42 AM 1986
MILDRED H. GODDARD
REGISTER OF DEEDS
SAGINAW COUNTY MICH
Register of Deeds Stamp & File Number

4. Lot No. _____, Recorded Plat _____
5. Private Claims _____

I, Brian D Ferguson, in a field survey on September 3, 1996 do hereby state that under requirements of P.A. 74, Michigan P.A. of 1970, the corner points mentioned in lines 1 and 2 above were in conformance with regulations and rules therefore as required in the current manual of survey instructions of the United States Department of the Interior, Bureau of Land Management or by a decree of a Court of Law and/or that the corner points mentioned in lines 3, 4 and 5 above were in conformance with the rules of the Michigan Board of Land Surveyors or by a Decree of a Court of Law; established, re-established, monumented, recovered, found as expressed below:

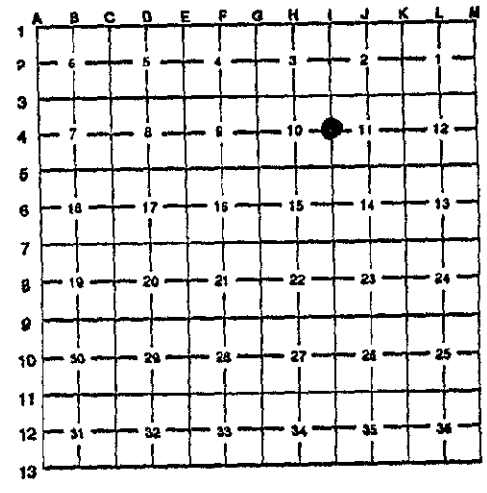

NOTE: Not more than 2 corners, all in the same town and range, may be recorded on this certificate.

A. Description of original monument and accessories and/or subsequent restoration:


I-4 Wood post set by Wampler, 1822.
LCRC L. 3, Pg. 76.

B. Description of corner evidence found and/or method applied in restoring or reestablishing corner:

I-4 Found 1" x 30" square bar.
Current position agrees with 1/2 mile distance from plat recorded L. 25, Pg. 6.
Accepted by per group as best available evidence of original corner.

C. Description of monument for corner and accessories established to perpetuate locating the position of the corner:

I-4 Set 5/8" steel bar with Saginaw County Remon. cap.
S63°E 32.82 N & S SW face power pole.
S18°W 75.33 N & S SE face 8" pine.
S47°W 63.91 N & S W face 12" pine.
N32°E 14.71 N & S W face 8" poplar.
N25°W 7.88 Centerline 45 mph sign.

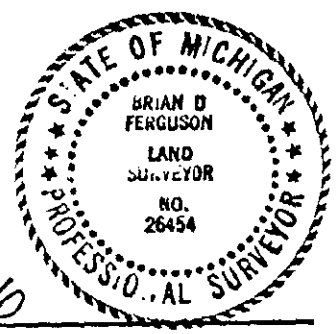

Signed by Brian D Ferguson
Surveyor's Michigan License No. 26454

Date 9-27-96

REMONUMENTATION

MAY 16 1997