

SAGINAW COUNTY REMONUMENTATION

8-7-96

LAND CORNER RECORDATION CERTIFICATE
Filing Requirement of Act 74, Mich. P.A. 1970


For corners in

Saginaw Located In: Thomas Twp. Corner Code #
(County)

- 1. Public Land Survey T 12N R 3E I-5
- 2. Property Controlling S T R
in Section S T R
- 3. Miscellaneous S T R
Property in Sec. S T R

RECORDED & FILED
 SEP 27 11 42 AM 1996
 MILDRED H. DOBARK
 REGISTER OF DEEDS
 SAGINAW COUNTY MICH.
 Liber 7 Page 67
 Register of Deeds Stamp & File Number

- 4. Lot No. _____, Recorded Plat _____
- 5. Private Claims _____

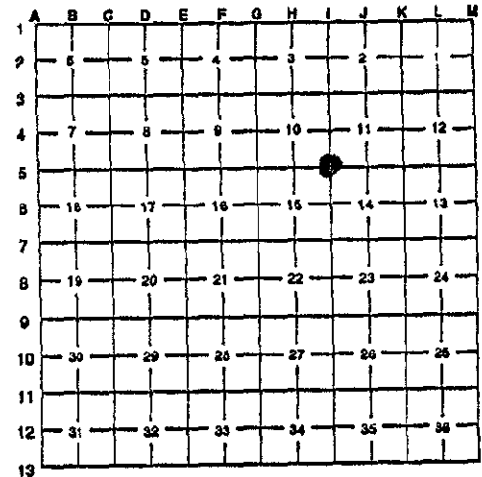

I, Brian D Ferguson, in a field survey on September 3, 1996 do hereby state that under requirements of P.A. 74, Michigan P.A. of 1970, the corner points mentioned in lines 1 and 2 above were in conformance with regulations and rules therefore as required in the current manual of survey instructions of the United States Department of the Interior, Bureau of Land Management or by a decree of a Court of Law and/or that the corner points mentioned in lines 3, 4 and 5 above were in conformance with the rules of the Michigan Board of Land Surveyors or by a Decree of a Court of Law; established, re-established, monumented, recovered, found as expressed below:

NOTE: Not more than 2 corners, all in the same town and range, may be recorded on this certificate.

A. Description of original monument and accessories and/or subsequent restoration:


I-5 Wood post set by Wampler, 1822.
 Surveys L. 1589, Pg. 25; L. 1739, Pg. 1869; L. 1972, Pg. 67.
 Agrees with SCRC witnesses, 1973.

B. Description of corner evidence found and/or method applied in restoring or reestablishing corner:

I-5 Found bolt in monument box set by SCRC in 1974.
 Current position agrees with 1/2 mile distances from plat recorded in L. 25, Pg. 6.
 Accepted by peer group as best available evidence of original corner.

C. Description of monument for corner and accessories established to perpetuate locating the position of the corner:

I-5 Set 5/8" steel bar with Saginaw County Remon. cap in monument box.
 S45°W 54.02 NW corner brick wall.
 S45°E 88.05 N & S SW face power pole.
 N60°W 92.12 PK nail E face power pole.
 N70°W 123.50 Top ctr. hyd.

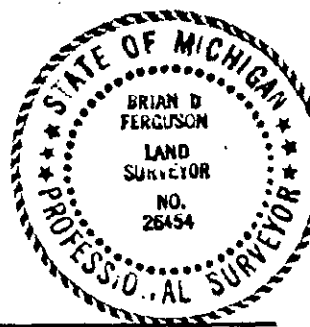

Signed by Brian D Ferguson
 Surveyor's Michigan License No. 26454

Date 9-27-96

REMONUMENTATION

MAY 16 1997