

APPROVED BY PEER GROUP SAGINAW COUNTY REMONUMENTATION

P.A. 345 OF 1990

LIBER 1956 PAGE 1129

Lib 7 Page 38

SAGINAW COUNTY

LAND CORNER RECORDATION CERTIFICATE

Filing Requirement of Act 74, Mich. P.A. 1970

11/29/95 RCF
For corners in Saginaw
(County)

Located In: Thomas Twp. Corner Code # _____

REGISTER OF DEEDS
SAGINAW COUNTY MICH.


Dec 20 12 36 PM '95

RECORDED & FILED

	12 N.	3 E.	I-10
1. Public Land Survey	T _____	R _____	_____
	T _____	R _____	_____
	T _____	R _____	_____
	T _____	R _____	_____
2. Property Controlling in Section	S _____	T _____	R _____
	S _____	T _____	R _____
3. Miscellaneous Property in Section	S _____	T _____	R _____
	S _____	T _____	R _____

Register of Deeds Stamp & File Number

- 4. Lot No. _____, Recorded Plat _____
- 5. Private Claims _____

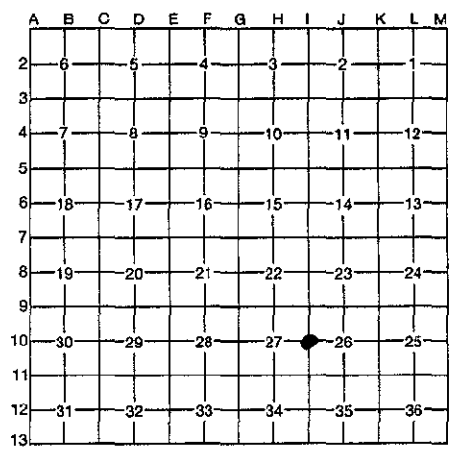

Ronald C. Prevost Nov. 29 95

I, _____, in a field survey on _____, 19_____, do hereby certify that under requirements of P.A. 74, Michigan P.A. of 1970, the corner points mentioned in lines 1 and 2 above were in conformance with regulations and rules therefore as required in the current manual of survey instructions of the United States Department of the Interior, Bureau of Land Management or by a decree of a Court of Law and/or that the corner points mentioned in lines 3, 4 and 5 above were in conformance with the rules of the Michigan Board of Professional Surveyors or by a Decree of a Court of Law; established, re-established, monumented, re-monumented, recovered, found as expressed below:

NOTE: Not more than 4 corners, all in the same town and range, may be recorded on this certificate.

A. Description of original monument and accessories and/or subsequent restoration:

I-10 Post Set by Wampler, 1822
Nail set by J.W. Martin (Spicer) 1953 (Gratiot Rd. Subdivision)
Shown on M.D.O.T. R/W Maps
Mon. Box w/ 5/8" Bar from Spicer notes 1976
L.C.R.C. L2 P2, Mon Box, McKelvey, 1972
Recorded survey L1523 P843

REMONUMENTATION

FEB 22 1996


COMMISSION

B. Description of corner evidence found and/or method applied in restoring or reestablishing corner:

I-10 Found RR spike in Mon Box
Witnesses from 1953 Spicer notes all gone.
See common witnesses in Section C.
Is accepted as the best available evidence of the position of the original corner.
Ratified by Saginaw Co Peer Group 11-29-95

C. Description of monument for corner and accessories established to perpetuate locating the position of the corner:

I-10 Replaced RR Spike with 5/8" Re-Rod, Saginaw County Brass Cap in existing Mon Box. 12-4-95
N.20°W. 85.10 Nail SE Face P & T Pole (85.10R Spicer 1976 Notes)
N.20°E. 83.27 Nail SW Face P & T Pole (83.27R Spicer 1976 notes)
North 2.85 Centerline joint W bound lane.
East 55.29 Expansion joint

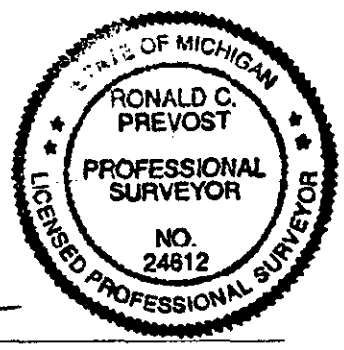

Signed by Ronald C. Prevost
24612

Date 12-27-95

Surveyor's Michigan License No. _____