

SAGINAW COUNTY REMONUMENTATION

LAND CORNER RECORDATION CERTIFICATE

Filing Requirement of Act 74, Mich. P.A. 1970

For corners in

Saginaw Located in: Thomas Twp. Corner Code #
(County)

- 1. Public Land Survey T 12N R 3E J-5
T _____ R _____
- 2. Property Controlling S _____ T _____ R _____
In Section S _____ T _____ R _____
- 3. Miscellaneous S _____ T _____ R _____
Property in Sec. S _____ T _____ R _____

- 4. Lot No. _____, Recorded Plat _____
- 5. Private Claims _____

I, Brian D Ferguson, in a field survey on September 3, 1996 do hereby state that under requirements of P.A. 74, Michigan P.A. of 1970, the corner points mentioned in lines 1 and 2 above were in conformance with regulations and rules therefore as required in the current manual of survey instructions of the United States Department of the Interior, Bureau of Land Management or by a decree of a Court of Law and/or that the corner points mentioned in lines 3, 4 and 5 above were in conformance with the rules of the Michigan Board of Land Surveyors or by a Decree of a Court of Law; established, re-established, monumented, recovered, found as expressed below:

NOTE: Not more than 2 corners, all in the same town and range, may be recorded on this certificate.

A. Description of original monument and accessories and/or subsequent restoration:

- J-5 Wood post set by Wampler, 1822.
LCRC L. 3, Pg. 76.
Surveys L. 1589, Pg. 23; L. 1589, Pg. 25.

B. Description of corner evidence found and/or method applied in restoring or reestablishing corner:

- J-5 Found 3/4" pipe in monument box.
Current position agrees with 1/2 mile distance from plat recorded L. 25, Pg. 6.
Accepted by peer group as best available evidence of original corner.

C. Description of monument for corner and accessories established to perpetuate locating the position of the corner:

- J-5 Set 5/8" steel bar with Saginaw County Remon. cap.
S60°W 73.00 NE face fence post.
S45°E 29.20 N & S W face guard rail post.
N30°E 108.79 N & S SE face power / light pole.
N45°W 70.78 N & S S face power pole.


Signed by Brian D Ferguson
Surveyor's Michigan License No. 26454

Date 9-27-96

RECORDED & FILED
 SEP 27 11 41 AM 1996
 MILDRED M. DODAK
 REGISTER OF DEEDS
 SAGINAW COUNTY HIGH

Liber 7 Page 61
Register of Deeds Stamp & File Number

1	A	B	C	D	E	F	G	H	I	J	K	L	M
2	6		5		4		3		2				
3													
4	7		8		9		10		11		12		
5													
6	14		17		16		15		14		13		
7													
8	19		20		21		22		23		24		
9													
10	30		29		28		27		26		25		
11													
12	31		32		33		34		35		36		
13													

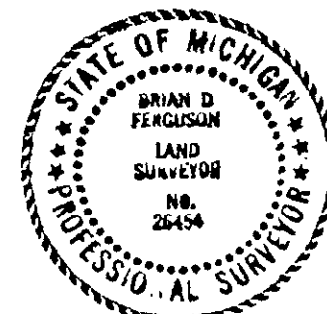

MAY 1 6 1997

COMPL.