

APPROVED BY PEER GROUP P.A. 345 OF 1990 SAGINAW COUNTY REMONUMENTATION PROJECT

LIBER 1924 PAGE 783

LAND CORNER RECORDATION CERTIFICATE Filing Requirement of Act 74, Mich. P.A. 1970

DEC 14 4 07 PM '94

MILLER ROAD REGISTER OF DEEDS SAGINAW COUNTY MICH.

For corners in Saginaw (County) REMONUMENTATION

Corner Code #

APR 24 1995

- 1. Public Land Survey T 12N R 3E
2. Property Controlling in Section S T R
3. Miscellaneous Property in Sec. S T R

Table with 1 column and 3 rows for Corner Code #, containing lines for recording.

Handwritten: Liber 6 Page 237

Register of Deeds Stamp & File Number

- 4. Lot No. Recorded Plat
5. Private Claims

Grid table with columns A-M and rows 1-13 for recording corners.

I, John H. Rauser, in a field survey on June 1 19 94, do hereby certify that under requirements of P.A. 74, Michigan P.A. of 1970, the corner points mentioned in lines 1 and 2 above were in conformance with regulations and rules therefore as required in the current manual of survey instructions of the United States Department of the Interior, Bureau of Land Management or by a decree of a Court of Law and/or that the corner points mentioned in lines 3, 4 and 5 above were in conformance with the rules of the Michigan Board of Land Surveyors or by a Decree of a Court of Law; established, re-established, monumented, re-monumented, recovered, found as expressed below:

NOTE: Not more than 4 corners, all in the same town and range, may be recorded on this certificate.

A. Description of original monument and accessories and/or subsequent restoration:


(K-8) 1/4 cor., Sec. 23 & 24, T12N-R3E
Wood post set by J. Wampler, Deputy Surveyor, 1822
N30°E 6 lks. (3.96') White Oak
S30°W 15 lks. (9.9') Red Oak
1955 Plat of Evergreen Park Sub., rec. in L. 9, pg. 20, Saginaw County Records.
1969 Plat of Timber Acres, rec. in L. 15, pg. 18-20, Saginaw County Records.
1973 L.C.R.C. by Donald E. Sagasser, P.S. #14770, Saginaw County Road Commission, rec. in L. 2, pg. 88, Saginaw County Records.
1978 Act 132 by John W. Martin, P.S. #4699, rec. in L. 1553, pg. 544-546, Saginaw County Records
1979 L.C.R.C. by Ronald C. Prevost, P.S. #24612, rec. in L. 4, pg. 199, Saginaw County records
1986 Act 132 by B. D. Ferguson, P.S. #26454, rec. in L. 1681, pg. 397, Saginaw County Records.
1986 Act 132 by B. D. Ferguson, P.S. #26454, rec. in L. 1681, pg. 398, Saginaw County Records.

B. Description of corner evidence found and/or method applied in restoring or reestablishing corner:

(K-8) 1/4 cor., Sec. 23 & 24, T12N-R3E
Found no evidence of original government corner. Found 3/4" pipe in mon. box 4' +/- West of centerline of Miller Road as per record as stated in "A" above and is accepted as the best available evidence of the position of the original corner.

C. Description of monument for corner and accessories established to perpetuate locating the position of the corner:

(K-8) 1/4 cor., Sec. 23 & 24, T12N-R3E
Reset 5/8" rerod w/brass cap stamped Saginaw County Monument, P.S. #39096 in existing Monument Box.
N50°E 36.94' Set PK w/tag #39096 in SE fc. Utility Pole
N53°E 58.16' Enc. 1/2" conc. monument
S60°W 106.74' NE cor. brick house
S30°E 100.34' NW cor. brick house #7983
N40°W 47.22' End. 3/4" pipe

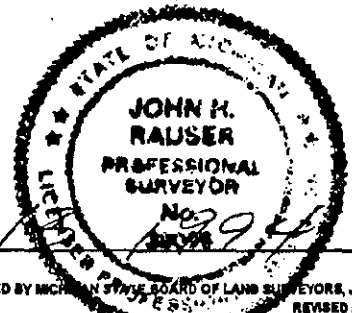

Signed by John H. Rauser Date Jan 1995
Surveyor's Michigan License No. 39096