

SAGINAW COUNTY REMONUMENTATION

LAND CORNER RECORDATION CERTIFICATE
Filing Requirement of Act 74, Mich. P.A. 1970

Sheet 6 Page 281

For corners in **SURVEY & REMONUMENTATION**
Saginaw County Located In:

Corner Code #

- | | | | | | | |
|------------------------------------|-------------|---|-----|---|----|------|
| 1. Public Land | APR 24 1995 | T | 12N | R | 3E | K-13 |
| | | T | | R | | |
| | | T | | R | | |
| | | T | | R | | |
| 2. Property Controlling in Section | S | T | | R | | |
| | S | T | | R | | |
| 3. Miscellaneous Property in Sec. | S | T | | R | | |
| | S | T | | R | | |

REGISTERED & FILED
 DEC 29 9 29 AM '94
 MICHIGAN BOARD OF LAND SURVEYORS
 REGISTER OF DEEDS
 SAGINAW COUNTY MICH.

Register of Deeds Stamp & File Number

4. Lot No. _____, Recorded Plat _____
5. Private Claims _____

	A	B	C	D	E	F	G	H	I	J	K	L	M
2	6		5		4		3		2		1		
3													
4	7		8		9		10		11		12		
5													
6	18		17		16		15		14		13		
7													
8	19		20		21		22		23		24		
9													
10	30		29		28		27		26		25		
11													
12	31		32		33		34		35		36		
13													

I, Duane F. Ledy, in a field survey on July 28, 19 94, do hereby certify that under requirements of P.A. 74, Michigan P.A. of 1970, the corner points mentioned in lines 1 and 2 above were in conformance with regulations and rules therefore as required in the current manual of survey instructions of the United States Department of the Interior, Bureau of Land Management or by a decree of a Court of Law and/or that the corner points mentioned in lines 3, 4 and 5 above were in conformance with the rules of the Michigan Board of Land Surveyors or by a Decree of a Court of Law; established, re-established, monumented, re-monumented, recovered, found as expressed below:

NOTE: Not more than 4 corners, all in the same town and range, may be recorded on this certificate.

A. Description of original monument and accessories and/or subsequent restoration:

K-13 Set post 80 chains west from M-13, J. Wampler, 1822:
 16" Elm N 79° E 14 links.
 15" R.Oak S 79° W 14 links.
 Saginaw County Surveyor, H. Cary, witnessed corner in 1875:
 14" Sugar S 3¼° E 24 links.
 12" Elm N 89½° E 40½ links.
 R. Sides witnessed a 1" iron pipe, 1972, L.C.R.C.: L1, P149.
 G. McKelvey found ¾" iron pipe, 1972: L1358, P448.
 Leach found ¾" pipe, 9.03' west of ¾" pipe, 1983: L1632, P1089.


B. Description of corner evidence found and/or method applied in restoring or reestablishing corner:

K-13 Found ¾" iron pipe in monument box.
 Found recorded witnesses as follows:
 East 9.21' to ¾" pipe in monument box (9.03'R).

 Existing monument accepted as best possible position of original corner
 Existing monument position accepted by Saginaw County Peer Review Group on December 7, 1994.

C. Description of monument for corner and accessories established to perpetuate locating the position of the corner:

K-13 Replaced ¾" pipe with 3" Saginaw County brass cap in monument box.
 East 9.21' to Saginaw County Remonumentation cap (K-1).
 N 45° E 50.82' to nail and tag in utility pole.
 S 45° W 50.11' to nail and tag in utility pole.
 S 45° E 54.24' to nail and tag in utility pole.
 N 70° W 141.40' to PK nail in utility pole.

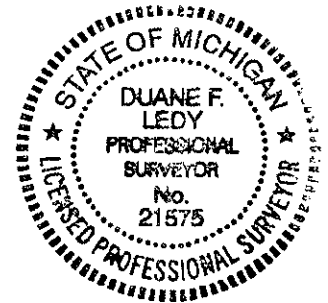

Signed by Duane F. Ledy Date December 28, 1994
 Surveyor's Michigan License No. 21575